

Name Craig Olmsted

Service No. 7

Address 54 MUNROE ROAD

54 Munroe Rd.

Location

Kind of Pipe

Size 6"

Size of Main 8"

~~XXXXXXXXXXXX~~ New Service Arlex 011 #3699

Location JUL 20 1982


Date	Material	Amount	Total	Date	Amount
3-5-65	17' 6" TRANSITE PIPE @ \$5.00		\$85.00	5-19-82	Deposit 85.00
5/20/82	30' 6" P.V.C. pipe				
	10" 4" C.I.P.			3-5-65	
	1 6" ACP x PVC Adaptor			17' 6" Transite	
	1 6" 22 1/2° Elbow PVC			1 6" x 8" Wye	
	1 6" 45° Elbow PVC				
	1 6" x 4" Donut				

DATE _____

TOWN OF LEXINGTON — BOARD OF PUBLIC WORKS
SEWER DIVISION

Sketch of Service Here

54

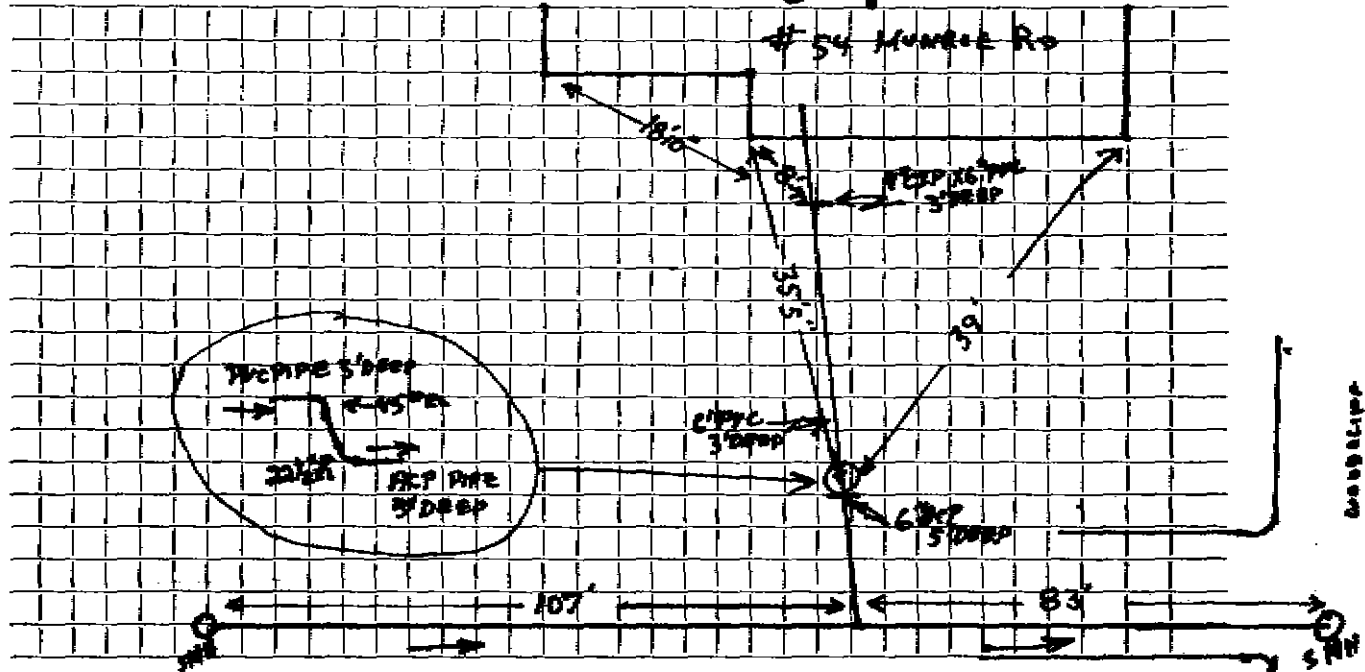

Connection made in Street. Work completed

Remarks: EDGE ON PROPERTY, PIPE OFFSET TO COME UP 3' DEEP INSIDE