

Name Ronald Schmitt

Service No. 88

Address 59 Munroe Road

59 Munroe Rd.

Location

Lot L.C. 27

Kind of Pipe

Size 6"

Size of Main 8"

Repair—Renewal—New Service DeFlice Bros. #1444

Location SEP 2 1969

| Date | Material | Amount | Total | Date | Amount |
|------------------|-----------------------------|------------------|-------|---------|-------------------|
| 65 16 | 6" Transite pipe | 25.00 | | | |
| 69 25 | 6" Transite pipe | | 82.50 | 8-21-69 | Deposit 105.00 |
| 10 | 4" Cast Iron pipe | | | 9-2-69 | Refund 22.50 |
| | | | | 3-5-65 | 82.50 |
| | | | | | 16.5- 6" Transite |
| | | | | | 1 6" X 8" Wye |


DATE _____

TOWN OF LEXINGTON — BOARD OF PUBLIC WORKS

SEWER DIVISION

Sketch of Service Here

59

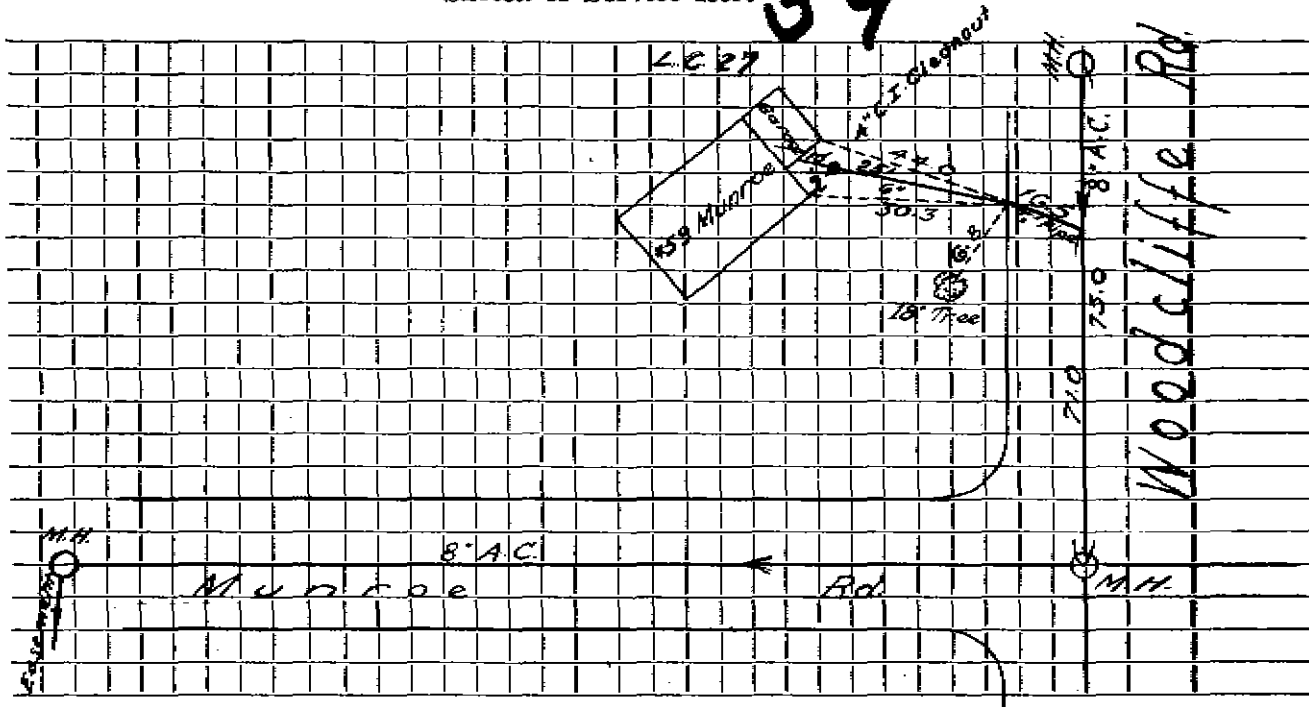

Connection made in Street. Work completed

Remarks:

.....

.....