

Name: Joseph E. Hickey (861-1438) Service No. 28

Address: 9 Munroe Rd.

Location: 9 Munroe Road

Kind of Pipe: _____ Size: 6" Size of Main: 8"

Repair: Renewal—New Service Lexington Sewerage #1847

Location: _____


JUL 26 1971

Date	Material	Amount	Total	Date		Amount
5/3/71	27' 6" Transite pipe 10' 4" Cast Iron pipe			5-2-71	Deposit	155
					21.3' 6" TRAN SITE	
					1 6"-45° BOND	
					1 6" X 8" WYE	
					21.3 feet 6" A.C.	
					Installed BY CONTRACTOR	
					@ 6.00 PER FOOT	127

DATE 2-2-99

TOWN OF LEXINGTON — BOARD OF PUBLIC WORKS
SEWER DIVISION

Sketch of Service Here

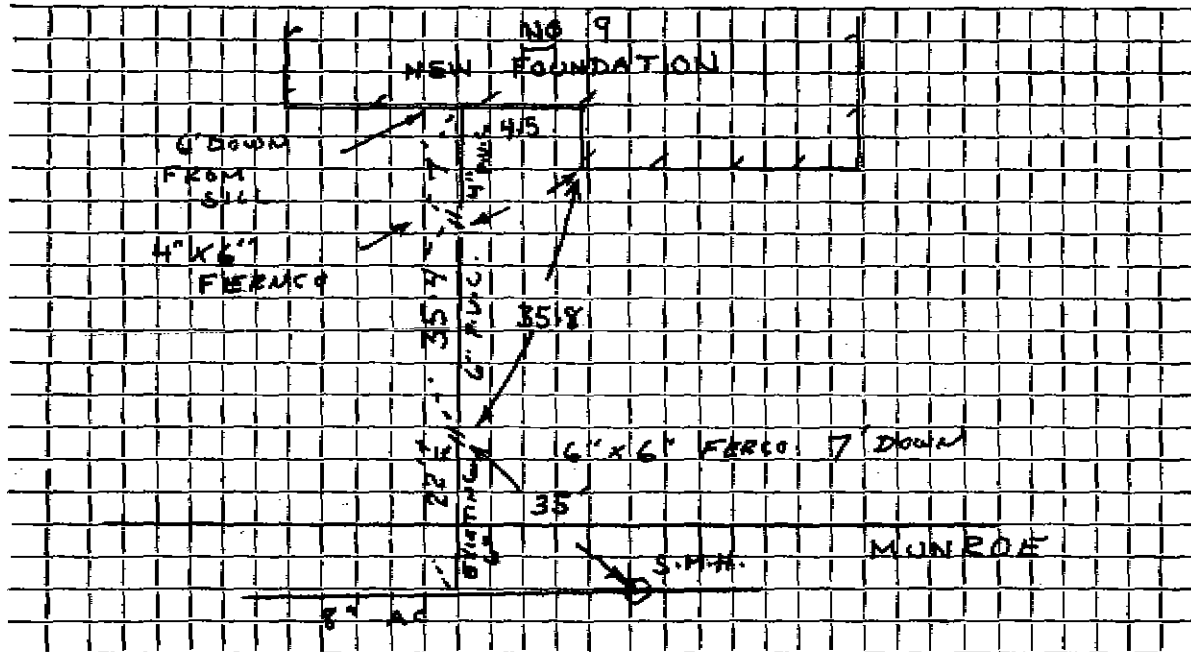

Connection made in ... MUNROE ... Street. Work completed

Remarks:

OK ~~99-1~~ 99-1


TAM

DATE _____

TOWN OF LEXINGTON — BOARD OF PUBLIC WORKS

SEWER DIVISION

Sketch of Service Here **9**

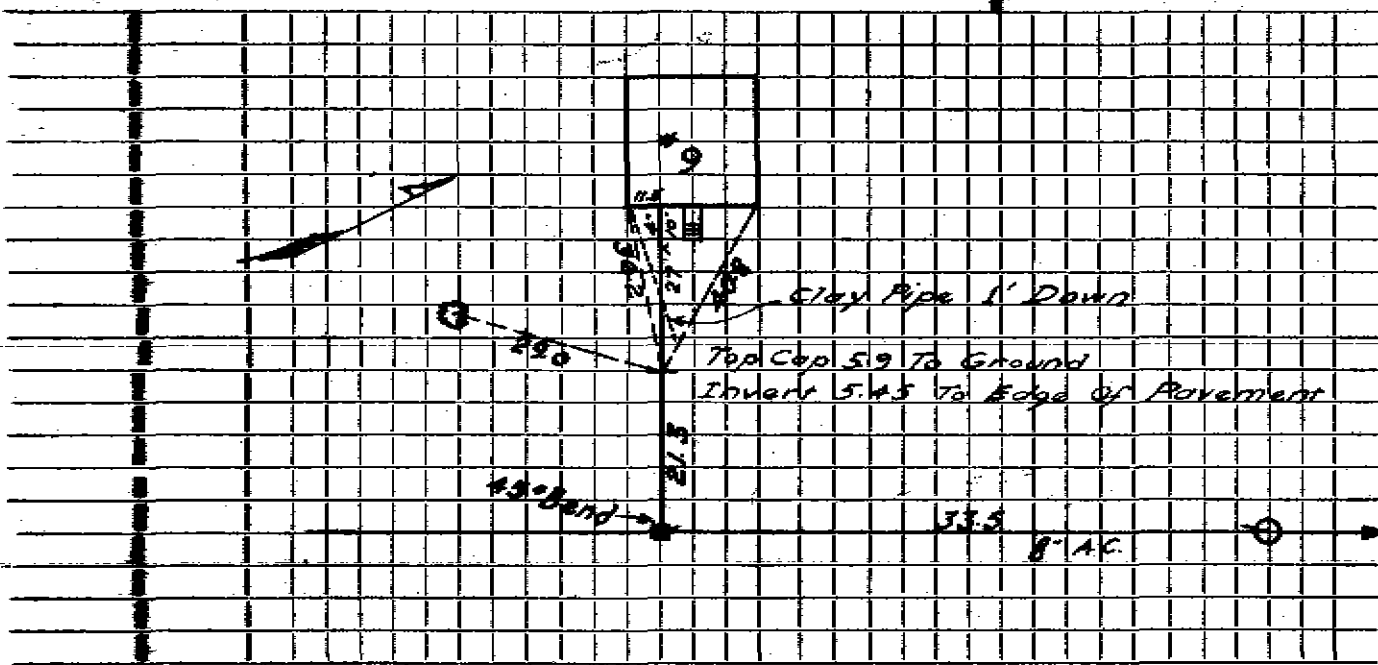

Connection made in _____ Street. Work completed _____

Remarks: _____