

Name **Fulton Brown**

Service No. **14 239**

Address **24 Arlington Street**

Winchester, Mass.

Location **9 Muzzey Street**

Kind of Pipe

Size

Size of Main

Repair—Renewal—New Service

Location

Date	Material	Amount	Total	Date	Amount
Aug. 22, '45	Labor	55 25		Aug 14 45	140 00
Aug. 23, '45	"	46 73		Dec 10 45	61 16
Aug. 24, '45	"	36 65			201 16
Aug. 25, '45	"	3 44	142 07		
	10% Overhead		14 21		
	64' - 6" Sewer Pipe @.22		14 08		
	10' - 4" Soil Pipe @.26		2 60		
	1 - 6" Elbow		70		
	Joint Compound		3 84		
	Compressor 4 hrs. @1.75		7 00		
	Trucking 8 hrs. @.75		6 00		
	Labor Patching 16' x 3'		10 66		
			201 16		

*Reported
paid*

201 16 9-24-45

TOWN OF LEXINGTON—DEPT. OF PUBLIC WORKS

SEWER DIVISION

DATE

NO.


The undersigned applies for the construction of a particular sewer connecting No. Street and hereby agrees to comply with the Rules and Regulations governing the construction and use of Particular Sewers, as now or at any future time established by the Board of Selectmen.

Am't of estimate \$.....

Am't Paid \$.....

..... Owner

Sketch of Service Here **9**

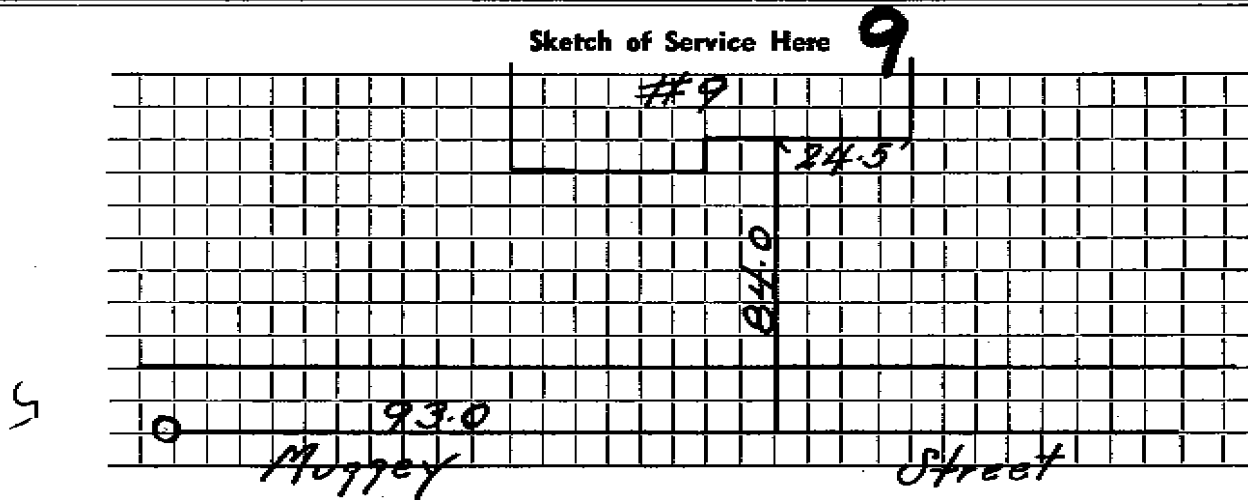

Connection made in Street.

Work completed 19..

Remarks: