

Name Bongiovanni Const. Co.

Service No. 19

Address 10 Muzzey St.

10 Muzzey ST.

Location Mail to: 30 Lincoln St., Boston, Ma.

Kind of Pipe

Size

Size of Main

Repair—Renewal—New Service W.O.# 638

Location Con 11-23-73

Date	Material	Amount	Total	Date	Amount
3/28/73	Labor	130 19		3-28-73	300 00
	Police	42 00		2-19-80	89 27
	10% O.H.	17 21	189 40		389 27
	20' 6" transite @	90	18 00		
	1 3x6 nipple w/cplg		4 00		
	1 6" cap		1 77		
	2 ton binder @ 8.00		16 00	OUTSIDE - NO CHARGE	
	½ bag cement		1 00	3/28/73	153 31
	28x6 trench patched		111 60		12 00
	4 hours town shovel @	6 50	26 00		165 31
	1 hour compressor		5 00	8-30-99	Problem in service - ON
	1 hour loader		4 00		Building owners SIDE
	3 hours trucking @	3 00	9 00		
	1 hour roller		2 00		
	1 hour pickup @	1 50	1 50		
			389 27		


DATE \_\_\_\_\_

TOWN OF LEXINGTON — BOARD OF PUBLIC WORKS

SEWER DIVISION

Sketch of Service Here

10

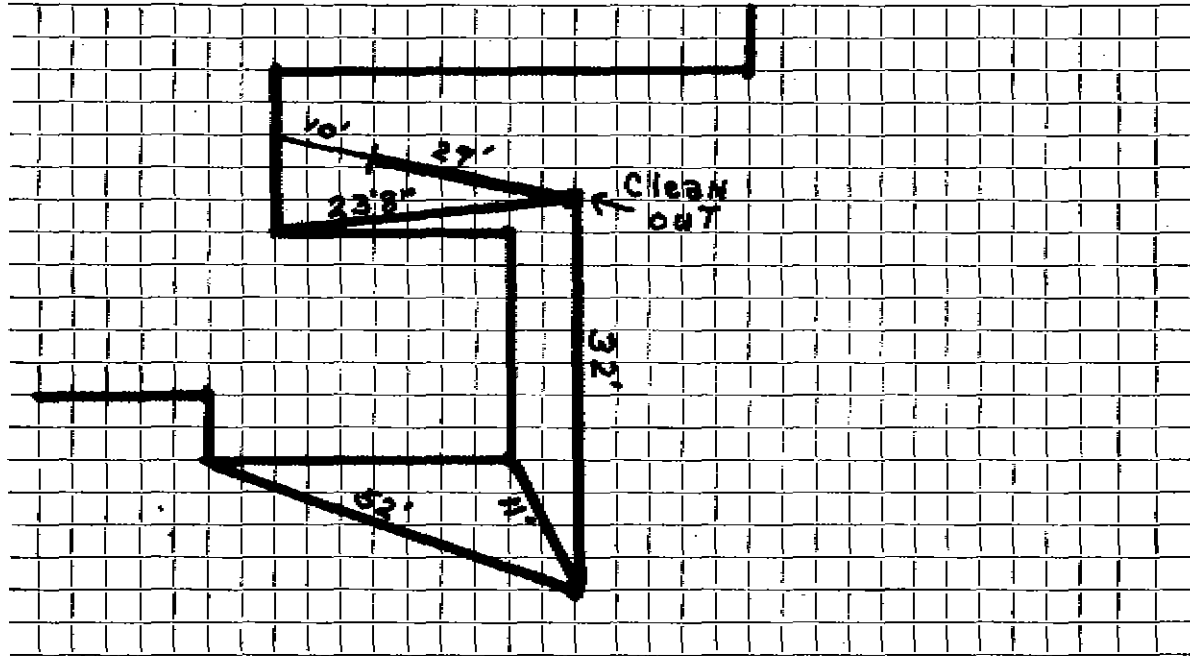

Connection made in ..... Street. Work completed .....

Remarks: .....

.....

.....