

Name Sasso Construction

Service No. 113

Address 19 Muzzey Street

19 Muzzey ST.

Location

Kind of Pipe

Size

Size of Main

~~Repair of Existing~~—New Service W.O. #9130

Location APR 20 1971


Date	Material	Amount	Total	Date	Amount	
11/23/70	Labor	120 87		10-30-71	Deposit	370 00
12/3/	"	14 02		4-30-71	Refund	130 68
12/3/	"	14 57	149 46	11-23-70		239 32
10%	O.H.		14 95	30'	6" TRANSITE	
30'	6" Transite pipe	90	27 00	1	6" Nipple	
1	6" Nipple		91	1	6" X Saddle	
1	Saddle		5 50			
1	Plug		3 80			
$\frac{1}{2}$	Bag cement 1.80		45			
1	Ton cold patch		6 00			
2 $\frac{1}{2}$	Ton hot top 6.00		15 00			
2 $\frac{1}{2}$	Hrs. Trucking 3.00		7 50			
$\frac{1}{2}$	" " 1.50		75			
1	" Compressor		5 00			
$\frac{1}{2}$	" Roller 2.00		1 00			
	Trailer		2 00			
			239 32			
-31-71	10' 6" Cast Iron pipe					

DATE _____

TOWN OF LEXINGTON — BOARD OF PUBLIC WORKS
SEWER DIVISION

Sketch of Service Here

19

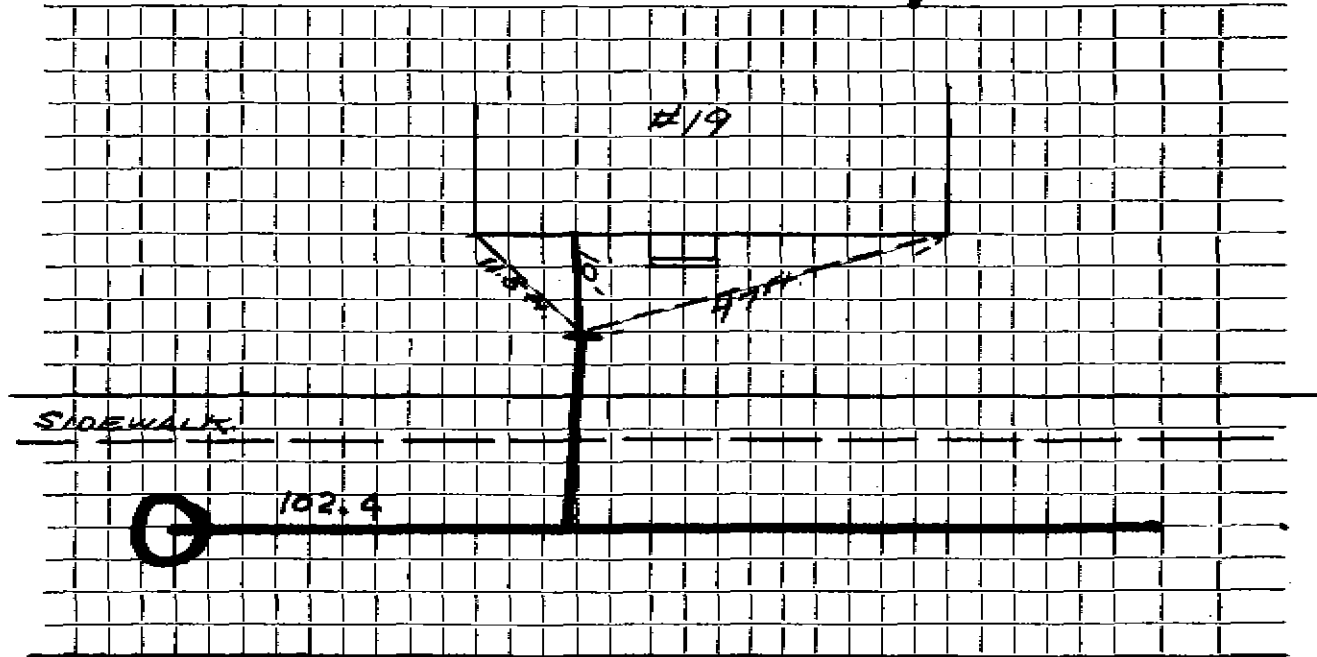

Connection made in Street. Work completed

Remarks:

.....

.....