

Name Stanley Phalen

Service No. 50

Address 21A Muzzey Street

21A Muzzey ST.

Location

Kind of Pipe

Size

Size of Main

~~Kind of Pipe~~ New Service W.O. #7964

Location Commo-28-63


Date	Material	Amount	Total	Date	Amount
5-23-63	Labor	76.76		5-20-63	Deposit 150.00
	10% O.H.	7.68	84.44	10-28-63	Paid by WH #39 14.04
30	6" Transite pipe @.82		24.60		<u>164.04</u>
2	hrs. Town Shovel @6.50		13.00		
2	hrs. Trucking @3.00		6.00		
17	x 3 Patch		17.00		
2	hrs. Town Shovel @6.50		13.00		
2	hrs. Trucking @3.00		6.00		
			<u>164.04</u>		

DATE _____

TOWN OF LEXINGTON — BOARD OF PUBLIC WORKS
SEWER DIVISION

Sketch of Service Here

21A

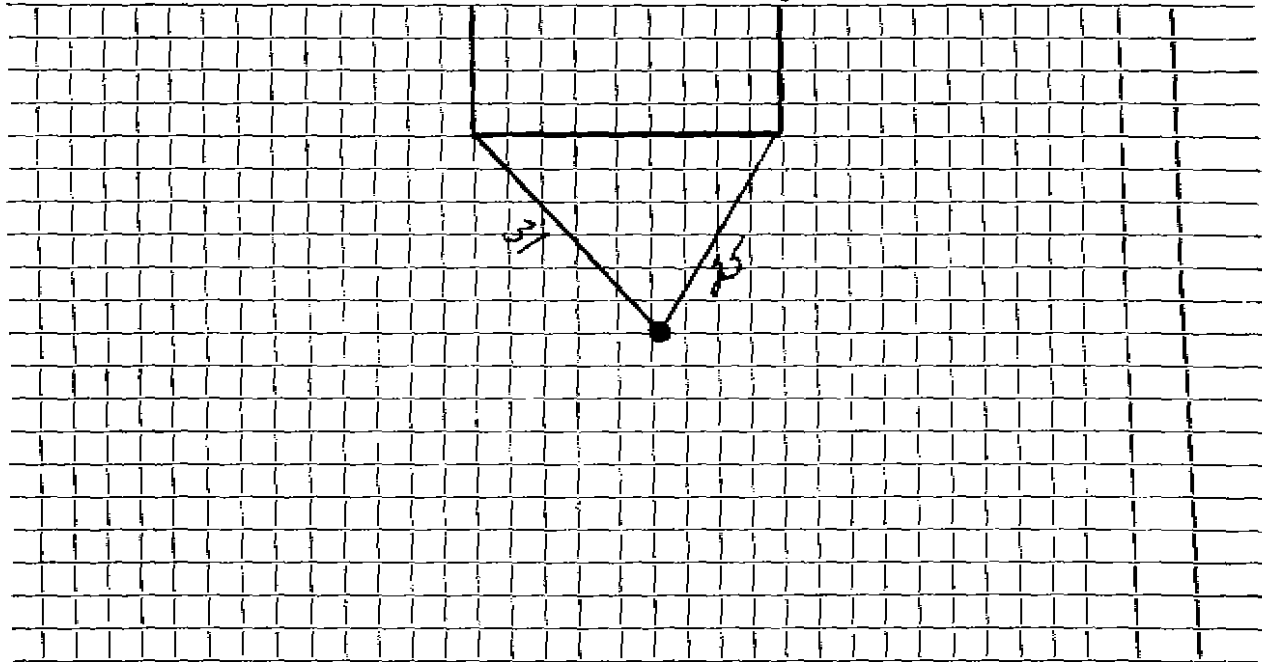

Connection made in Street. Work completed

Remarks:

.....

.....