

Name Daniel C. Yuill

Service No. 20

Address 22 Muzzey Street

22 Muzzey ST.

Location

Kind of Pipe

Size

Size of Main

~~Repaired~~ ^{Repaired} New Service

WO# 639

Location

MAY 29 1973

Date	Material	Amount	Total	Date	Amount
3/28/73 and	Labor	147 25			<u>NON CHARGE</u>
4/5/73	10% O. H.	14 73	161 98	5/28/73	labor 21 09
	36'-6" pipe @ .90		32 40		12"-6" pipe 10 80
	1/2-bag cement @ 1.98		99	3-28-73	Deposit 400 00
	2 doz-brick @ .07		1 68	5-29-73	Refund 131 95
	3 yards - loam @ 3.50		10 50		328 85
	5 lbs.-grass seed @ 1.10		5 50		
	5 1/2 yards-patching @ 6.00 yard		33 00		
	5 hours-trucking @ 3.00		15 00		
	2 hours-shovel @ 6.50		13 00		
	1/2 hour-roller @ 2.00		1 00		
	1/2 hour-loader @ 4.00		2 00		
	Trailer		1 00		
	Total Cost		278 05		
	Deposit		400 00		
	Refund due		121 95		


DATE _____

TOWN OF LEXINGTON — BOARD OF PUBLIC WORKS

SEWER DIVISION

Sketch of Service Here

22

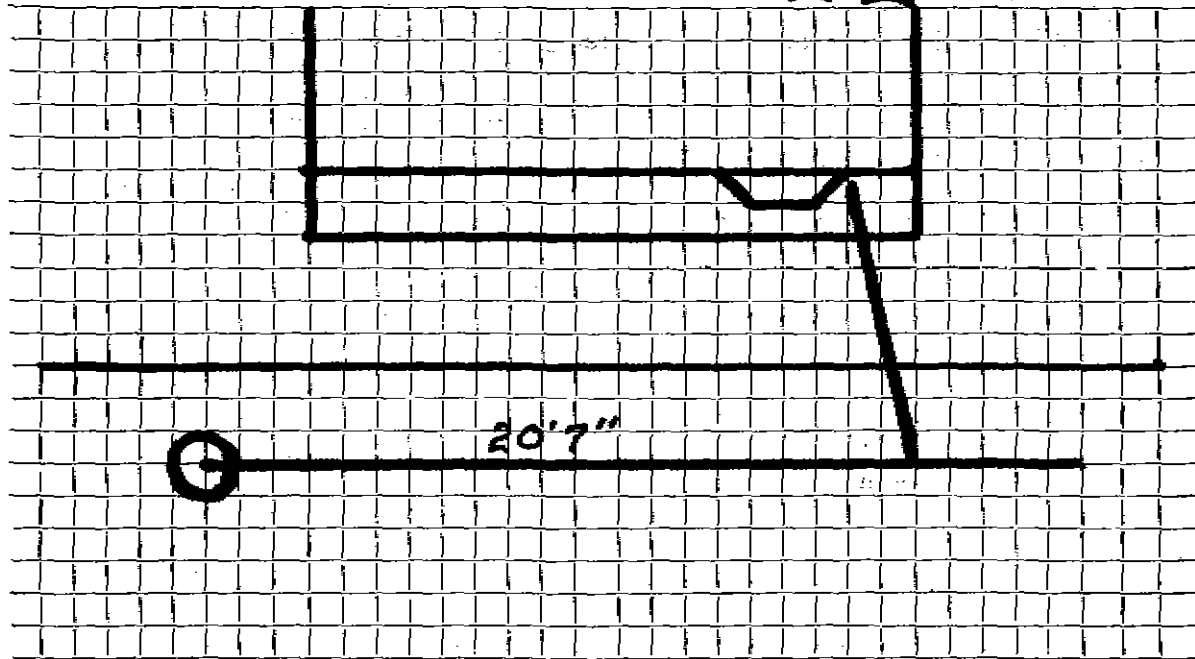

Connection made in Street. Work completed

Remarks:

.....

.....