

TOWN OF LEXINGTON—BOARD OF PUBLIC WORKS
SEWER DIVISION

DATE _____

NO. _____


The undersigned applies for the construction of a particular sewer connecting No. 27 Muzzy St. Street and hereby agrees to comply with the Rules and Regulations governing the construction and use of Particular Sewers, as now or at any future time established by the Board of Selectmen.

Am't. of Estimate \$ _____

Am't. Paid \$ _____

_____ Owner

Sketch of Service Here **27**

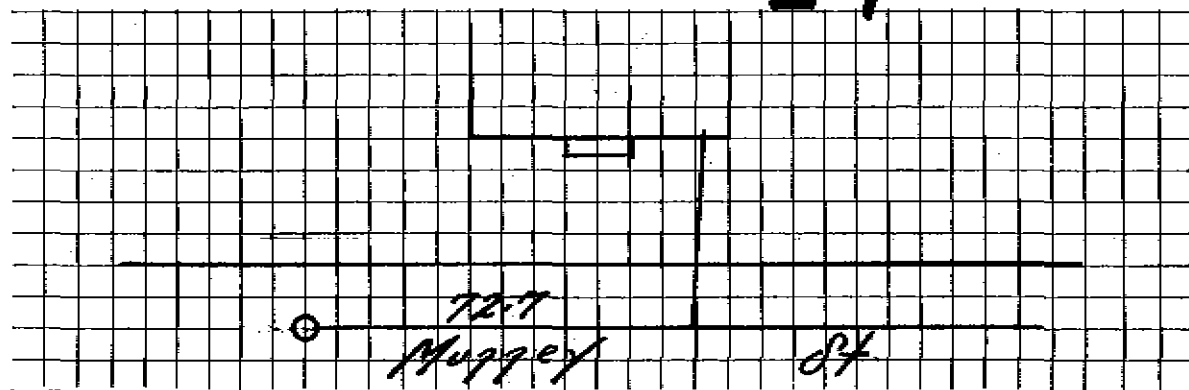

Connection made in _____ Street.

Work completed _____ 19

Remarks: