



TOWN OF LEXINGTON—BOARD OF PUBLIC WORKS

SEWER DIVISION

DATE \_\_\_\_\_

NO. \_\_\_\_\_

The undersigned applies for the construction of a particular sewer connecting No. 28 Muzgey St. Street and hereby agrees to comply with the Rules and Regulations governing the construction and use of Particular Sewers, as now or at any future time established by the Board of Selectmen.


Am't. of Estimate \$ \_\_\_\_\_

Am't. Paid \$ \_\_\_\_\_

Owner \_\_\_\_\_

Sketch of Service Here

28

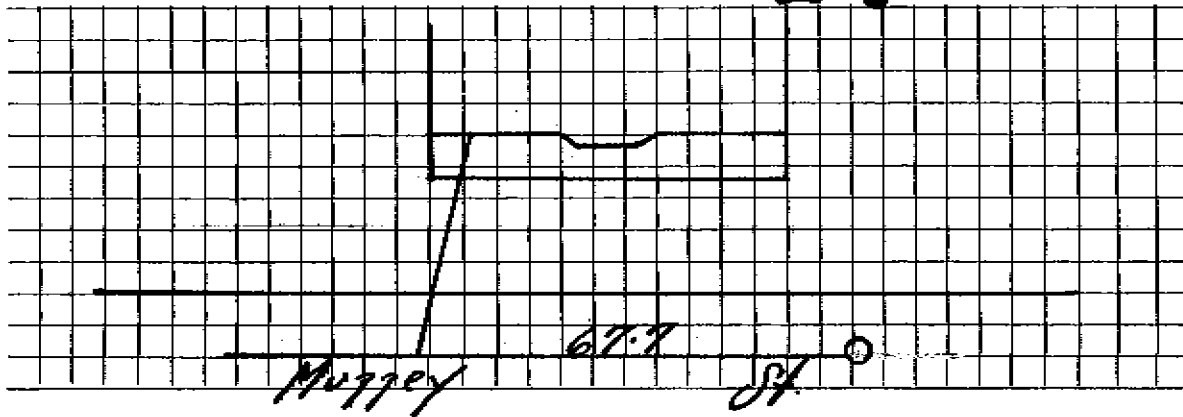

Connection made in \_\_\_\_\_ Street.

Work completed \_\_\_\_\_ 19

Remarks: