

Service No. 952

Name
Address 32 Muzzey St.

32 Muzzey St. Location 32 Muzzey Street

Kind of Pipe

Size

Size of Main

Repair—Renewal—New Service

Location

Date	Material	Amount	Total	Date	Amount
1929	Labor			8/19/27 4/16/03	S.A. Roofs 40' out Respond

TOWN OF LEXINGTON - BOARD OF PUBLIC WORKS

SEWER DIVISION

DATE _____

NO. _____


The undersigned applies for the construction of a particular sewer connecting No. 32 Muzzy St Street and hereby agrees to comply with the Rules and Regulations governing the construction and use of Particular Sewers, as now or at any future time established by the Board of Selectmen.

Am't. of Estimate \$ _____

Am't. Paid \$ _____

Owner _____

Sketch of Service Here **32**

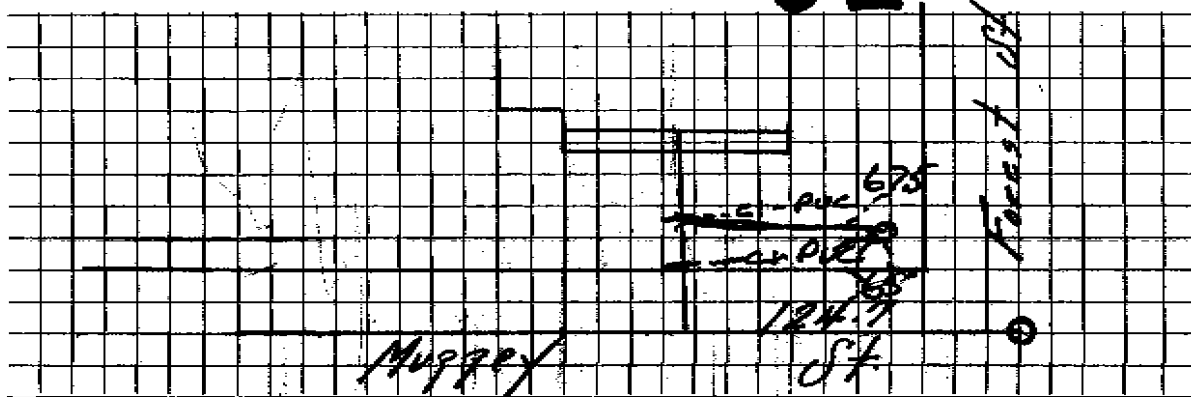

Connection made in _____ Street. Work completed _____ 19__

Remarks: Repair made from property line to edge of road 10 1/2" - 6" PVC curb stone right of way