




DATE \_\_\_\_\_

TOWN OF LEXINGTON — BOARD OF PUBLIC WORKS

SEWER DIVISION

Sketch of Service Here

33

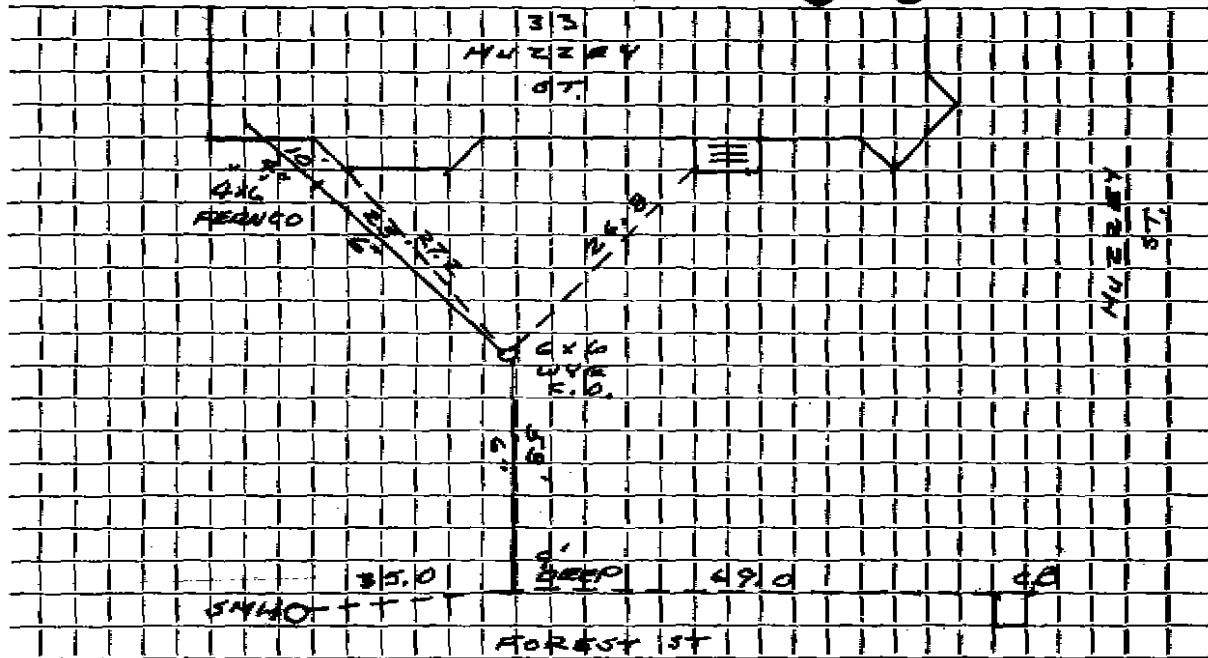

Connection made in FOREST Street. Work completed .....

Remarks: 33 MUZZEY = 19 FOREST ST.