


DATE _____

TOWN OF LEXINGTON — BOARD OF PUBLIC WORKS
SEWER DIVISION

Sketch of Service Here

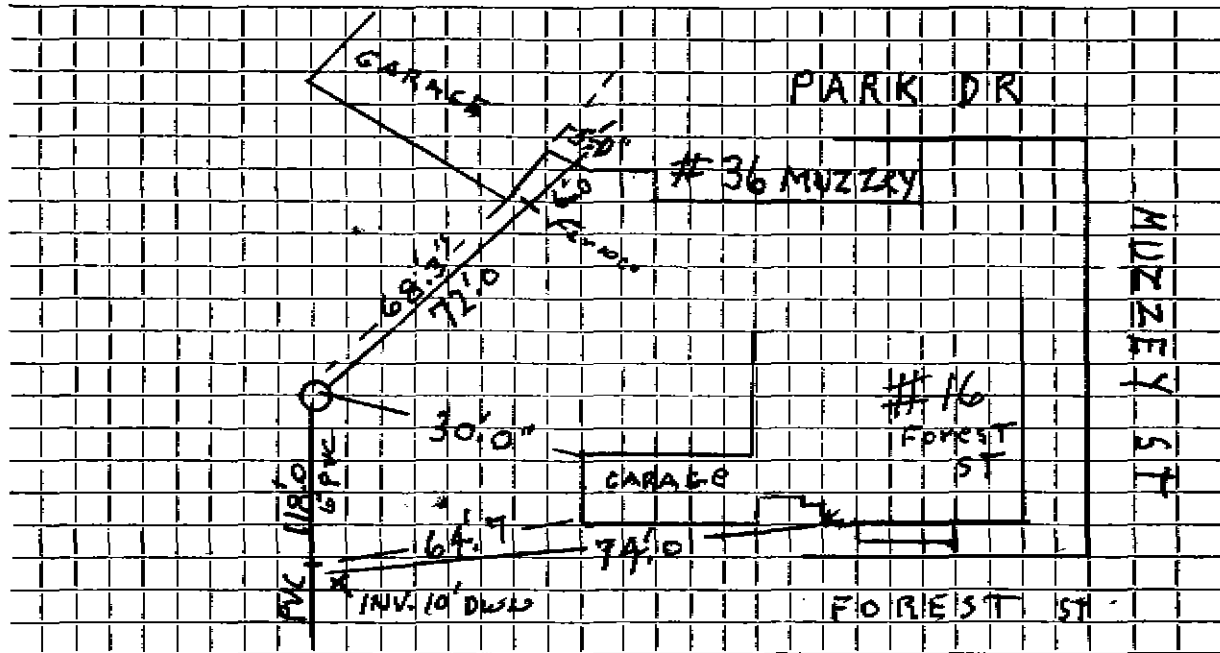

Connection made in Forest St Street.

Work completed 8/17/04 J. McLaughlin

Remarks:

.....

.....