

Name

Service No.

Address #2 Myrna Rd.

2 Myrna Rd.

Location

Kind of Pipe

Size

6" A.C.

Size of Main

8" A.C.

Repair—Renewal—New Service ✓


Location

Date	Material	Amount	Total	Date	Amount
<del>1-27-73</del>	<del>33' ac @ 8.90</del>	<del>#293.70</del>			
1-30-1998	Inside installed 26' 6" PVC 6' 4" PVC 6" x 4" PVC FENCED 6" x 6" PVC to AC FENCED			8-27-73	
				33' 6" TRANSITE	
				1 6" X 8" Wye	

DATE \_\_\_\_\_

TOWN OF LEXINGTON — BOARD OF PUBLIC WORKS  
SEWER DIVISION

Sketch of Service Here **2**

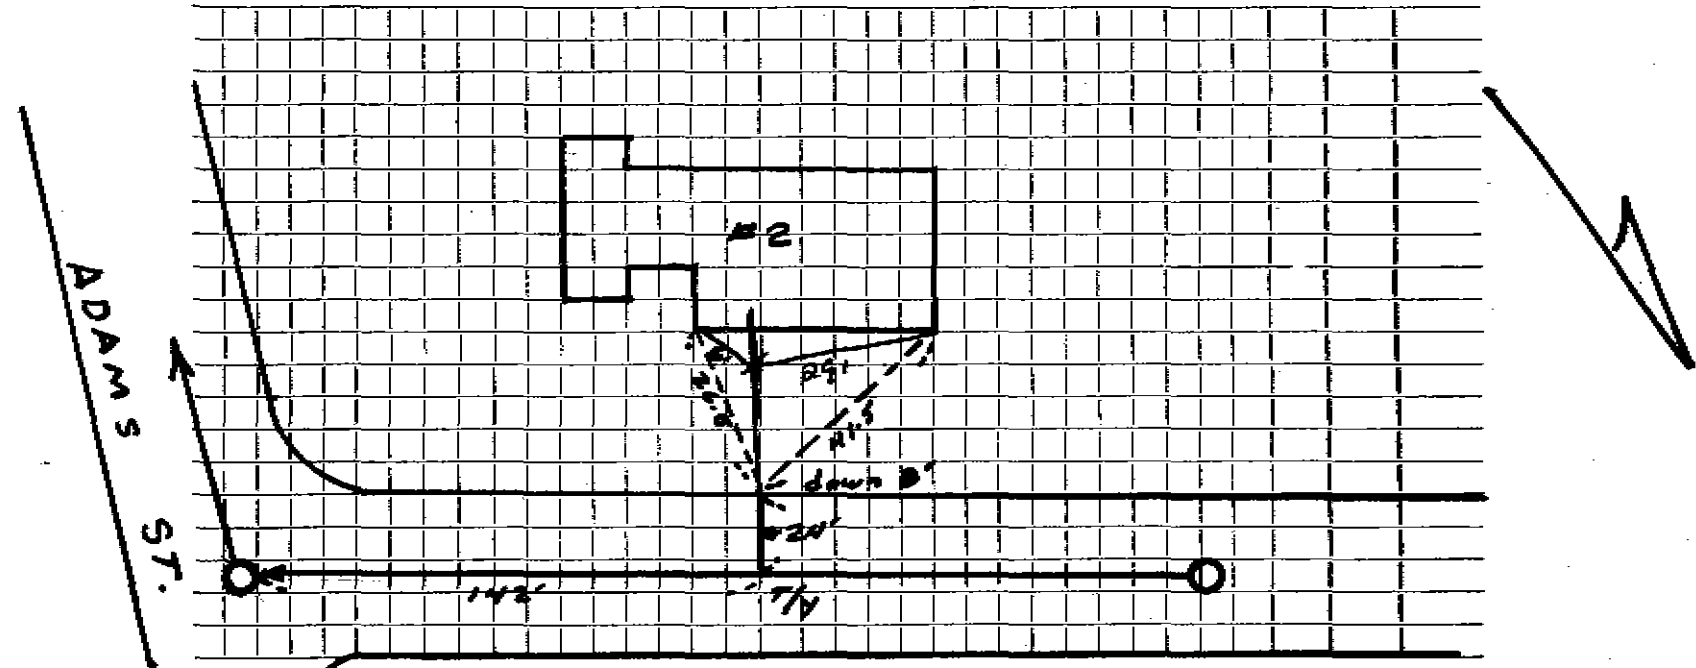

Connection made in ..... Street. Work completed .....

Remarks: .....  
.....  
.....