

Name Albert Sutcliffe

Service No. 134

Address #4 MYRNA RD.

4 Myrna Rd.

Location

Kind of Pipe A.C.

Size 6"

Size of Main 8"

Repair—Renewal—New Service Trebino #2357


Location NOV 19 1973

Date	Material	Amount	Total	Date	Amount
<del>12/1/73</del>	<del>22' @ \$8.90</del>	<del>#195.80</del>		10-3-73	Deposit 195.80
1/11/73	18' 6" Transite pipe			8-27-73	
	10' 4" Cast Iron pipe			22' 6" Transite	
				1 6" X 8" Wye	

DATE \_\_\_\_\_

TOWN OF LEXINGTON — BOARD OF PUBLIC WORKS  
SEWER DIVISION

Sketch of Service Here **4**

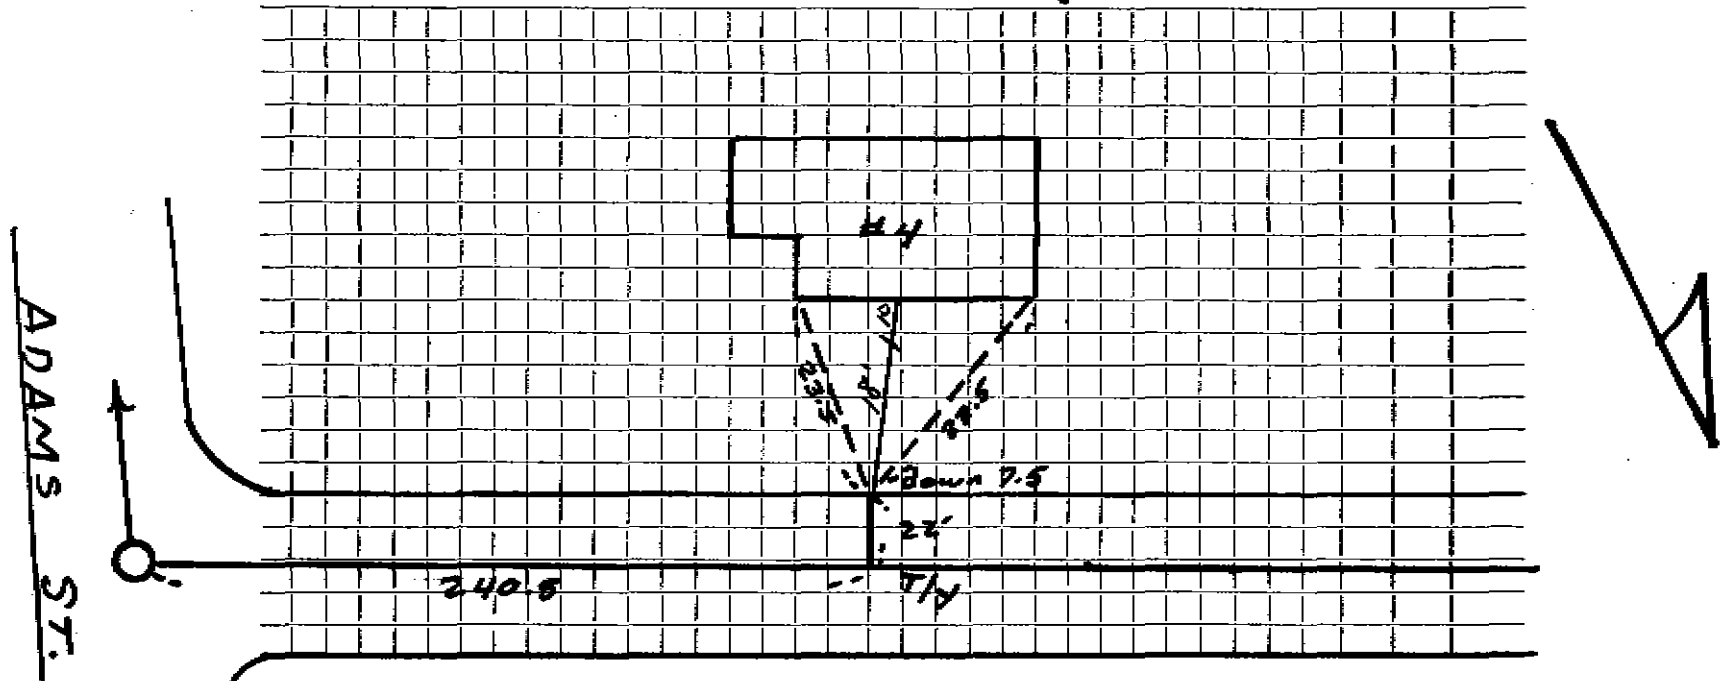

Connection made in ..... Street. Work completed .....

Remarks: .....  
.....  
.....