

Name Paul Carney

Service No. 175

Address #5 MYRNA RD.

5 Myrna Rd.

Location

Kind of Pipe

A.C.

Size

6"

Size of Main

8"

Repair—Renewal—New Service  Trabino Const. #2432


Location APR 8 1974

Date	Material	Amount	Total	Date	Amount
<del>12-17-73</del>	<del>27' @ \$8.90</del>	<del>\$241.30</del>		11-13-73	Deposit
-28-73	70' - 6" ACP				241.30
	8' - 4" CI			8-27-73	
					27' 6" Transite
					1 6" X 8" Wye

DATE \_\_\_\_\_

TOWN OF LEXINGTON — BOARD OF PUBLIC WORKS  
SEWER DIVISION

Sketch of Service Here

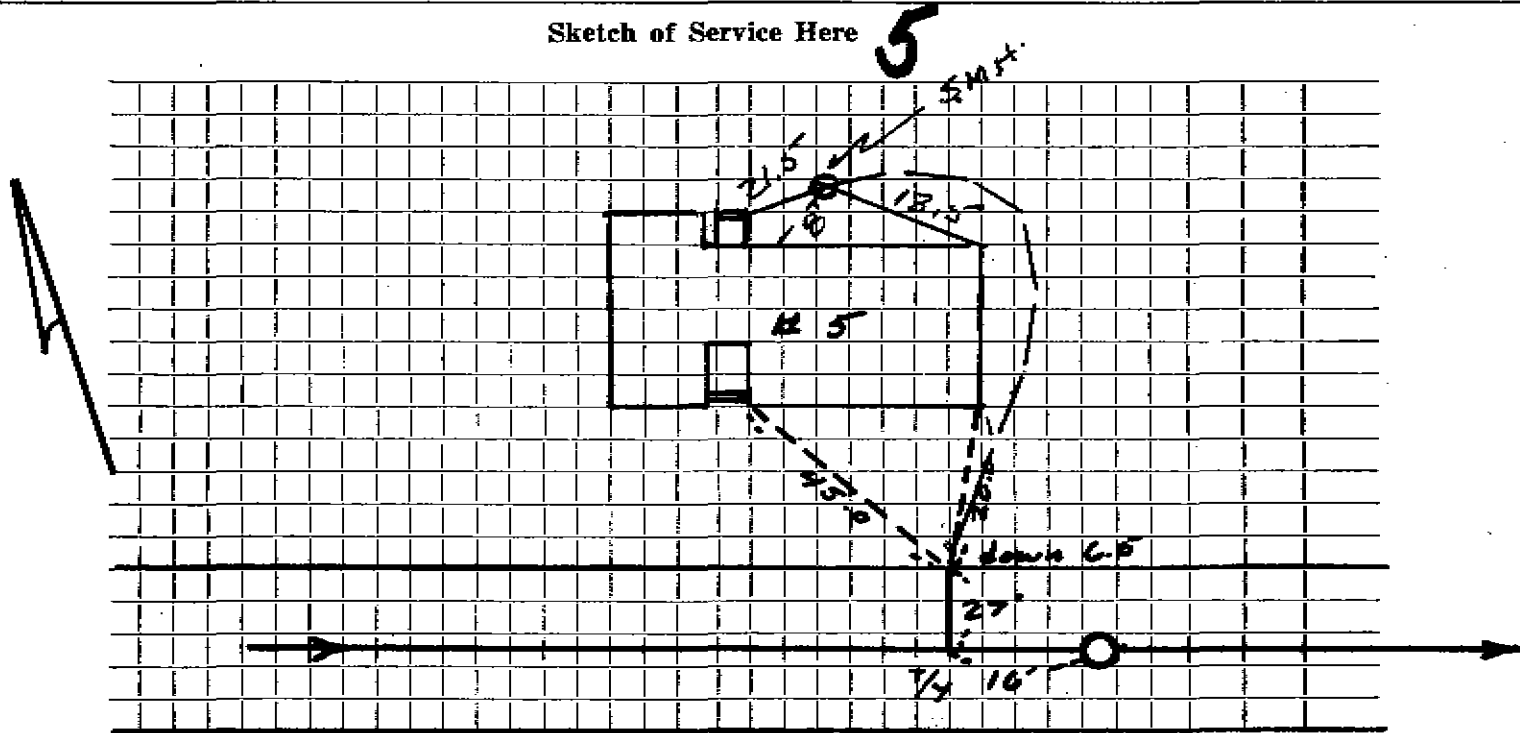

Connection made in ..... Street. Work completed .....

Remarks: .....

.....  
.....