

Name **Gurtis E. Carr**

Service No. **148**

Address **46 MYRNA RD.**

6 Myrna Rd.

Location

Kind of Pipe **A.C.**

Size **6"**

Size of Main **8" A.C.**

Repair—Renewal—New Service ✓ **Trebino Const. # 2414**


Location **APR 8 1974**

Date	Material	Amount	Total	Date	Amount	
12-17-73	24' @ \$8.90	\$213.60		11-19-73	Deposit	213.60
-12-73	28' - 6" ACP					
	10' - 4" CI			8-27-73	24' 6" Transite 1 6" x 8" Wye	

DATE _____

TOWN OF LEXINGTON — BOARD OF PUBLIC WORKS
SEWER DIVISION

Sketch of Service Here **6**

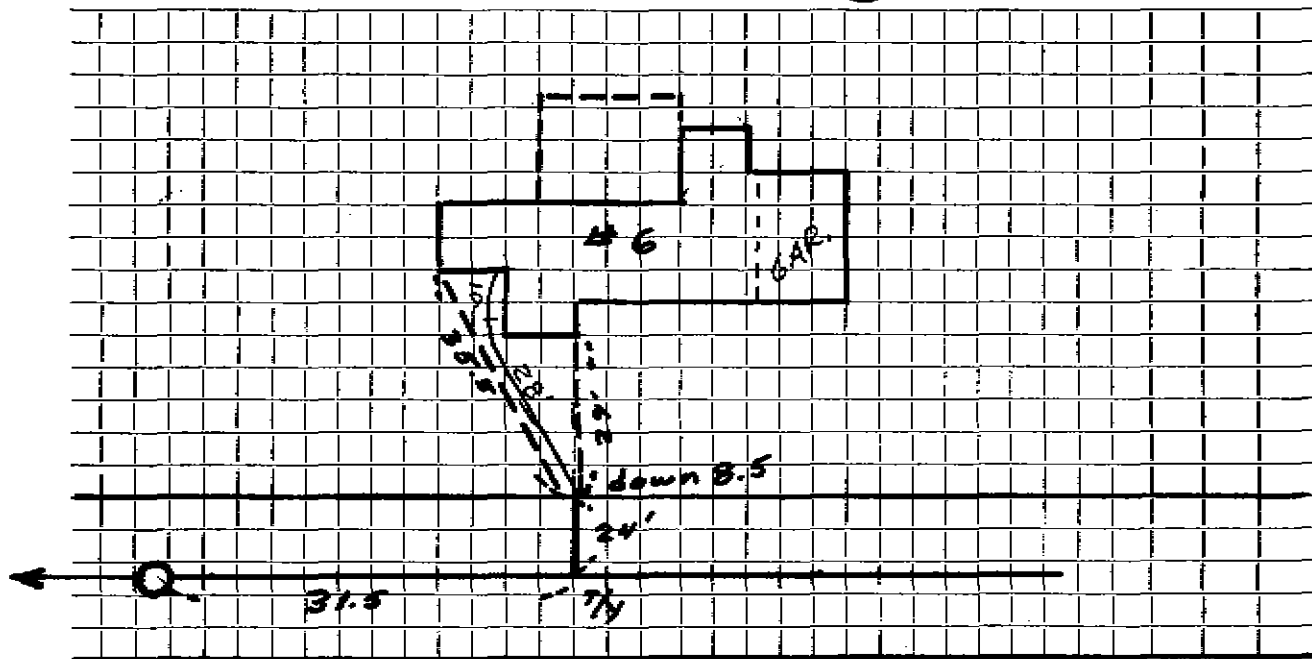

Connection made in Street. Work completed

Remarks:

.....

.....