

Name **Frederic Brown**

Service No. **7**

Address **48 MYRNA RD.**

Location

Kind of Pipe

A.C.

Size

6"

Size of Main

8"

~~Replacement~~ **New Service "Kirkland #3642"**

Location

MAY 26 1981

Date	Material	Amount	Total	Date	Amount	
1/29/73	20' @ \$12.90	\$241.30		4-6-81	Deposit	241.30
17/81	17' 6" PVC					
	10" 4" PVC			8-27-73		
	6" x 4" Donut				28' 6" Transite	
					1 6" x 8" Wye	


DATE _____

TOWN OF LEXINGTON — BOARD OF PUBLIC WORKS

SEWER DIVISION

Sketch of Service Here

8

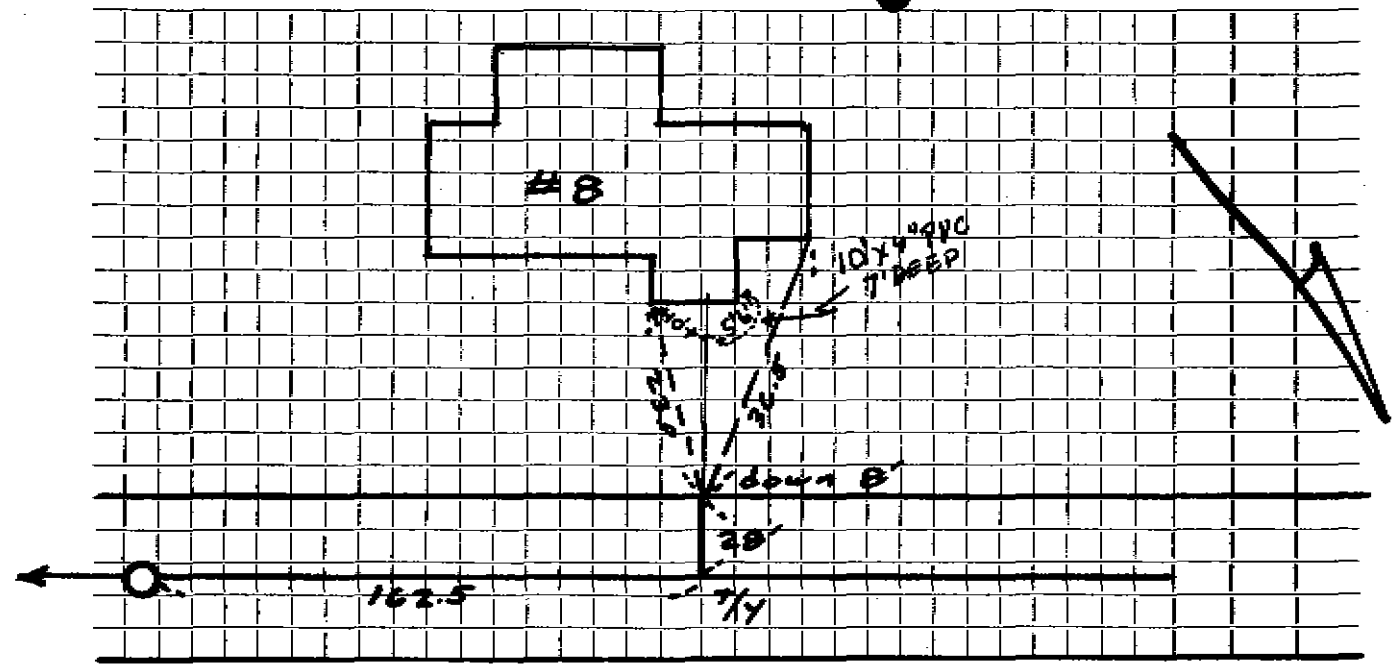

Connection made in Street. Work completed

Remarks:
.....
.....