

Name William Young

Service No. 142

Address #9 MYRNA RD.

9 MYRNA RD.

Location

Kind of Pipe A.C.

Size 6"

Size of Main 8"

Repair—Renewal—New Service ✓ Trebino #2409

Location NOV 19 1973


Date	Material	Amount	Total	Date	Amount	
<del>12/29/72</del>	<del>23' @ \$8.90</del>	<del>\$204.70</del>		11-15-73	Deposit	204.70
0/16/73	24' 6" Transite pipe			8-27-73	23' 6" Transite	
	10' 4" Cast Iron pipe				1 6"X8" Wye	

DATE \_\_\_\_\_

TOWN OF LEXINGTON — BOARD OF PUBLIC WORKS

SEWER DIVISION

Sketch of Service Here **9**

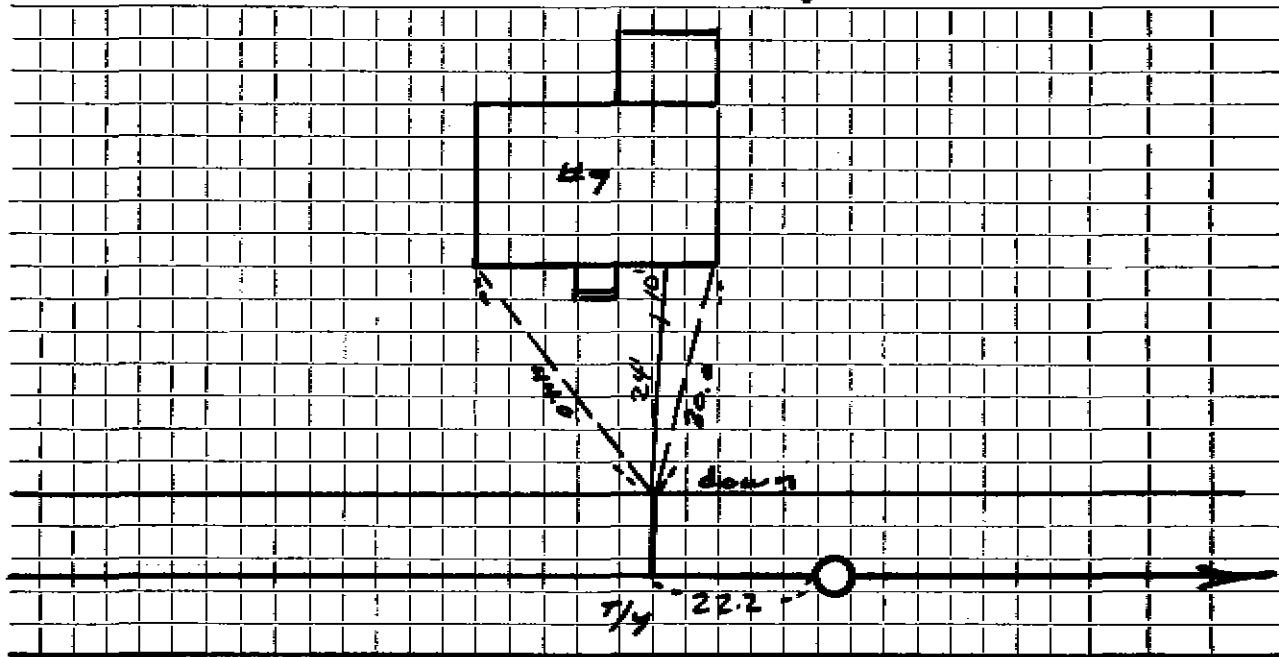

Connection made in ..... Street. Work completed .....

Remarks: .....

.....

.....