

Name John Shinnick

Service No. 12

Address 100 Myrtle Street

100 Myrtle St.

Location

Comm. 6-2-58

Kind of Pipe

Size

Size of Main

~~Repair—Renewal—New Service~~

Location

Date	Material	Amount	Total	Date	Amount
2/4/58	Labor	61 44		1-24-58	Deposit \$200.00
	10% overhead	6 14	67 58	6-2-58	Refund 38 70
	84 - 6" Transite Pipe @ .70		58 80		\$161 30
	1 - 22 $\frac{1}{2}$ " Transite Bend		6 21		
	1 - 6" Clay Elbow		1 88		
	1 - 6"x8" Y Branch		5 84		
	3 hrs. Town Shovel @ 6.50		19 50		
	2 hrs. Trucking @ .75		1 50		
			161 30		
	Labor				

TOWN OF LEXINGTON—DEPT. OF PUBLIC WORKS
SEWER DIVISION

DATE.....

NO.


The undersigned applies for the construction of a particular sewer connecting No.....
Street and hereby agrees to comply with the Rules and Regulations governing the construction and use of Particular
Sewers, as now or at any future time established by the Board of Selectmen.

Am't of estimate \$.....

Am't Paid \$.....

..... Owner

Sketch of Service Here

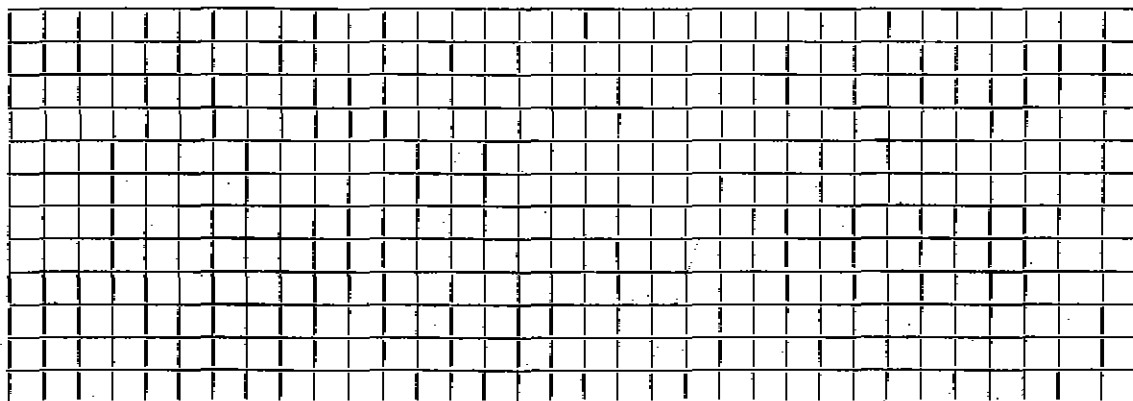

Connection made in..... Street.

Work completed..... 19..

Remarks: