

Name **Joseph Chisholm**

Service No. **197**

Address **76 Myrtle Street**

76 Myrtle ST.

Location

Kind of Pipe

Size

Size of Main

~~REPAIR SERVICE~~ — **New Service**

Location **C. 2-14-59**


Date	Material	Amount	Total	Date	Amount
10-13-59	Labor XXXX	37 84		10-6-59	Deposit 150 00
10-14-59	"	21 76		12-14-59	Retard 15 99
		59 60			134 01
	10% O. H.	5 96	65 56		
56'	6" Transite pipe @.70		39 20		
1	Bag Cement		1 50		
3	Hrs. Town Shovel @6.50		19 50		
1	Hr. Trucking @3.00		3 00		
1	Hr. Rogers Trailer @3.00		3 00		
3	Hrs. Trucking @.75		2 25		
			134 01		

DATE _____

TOWN OF LEXINGTON — BOARD OF PUBLIC WORKS

SEWER DIVISION

Sketch of Service Here

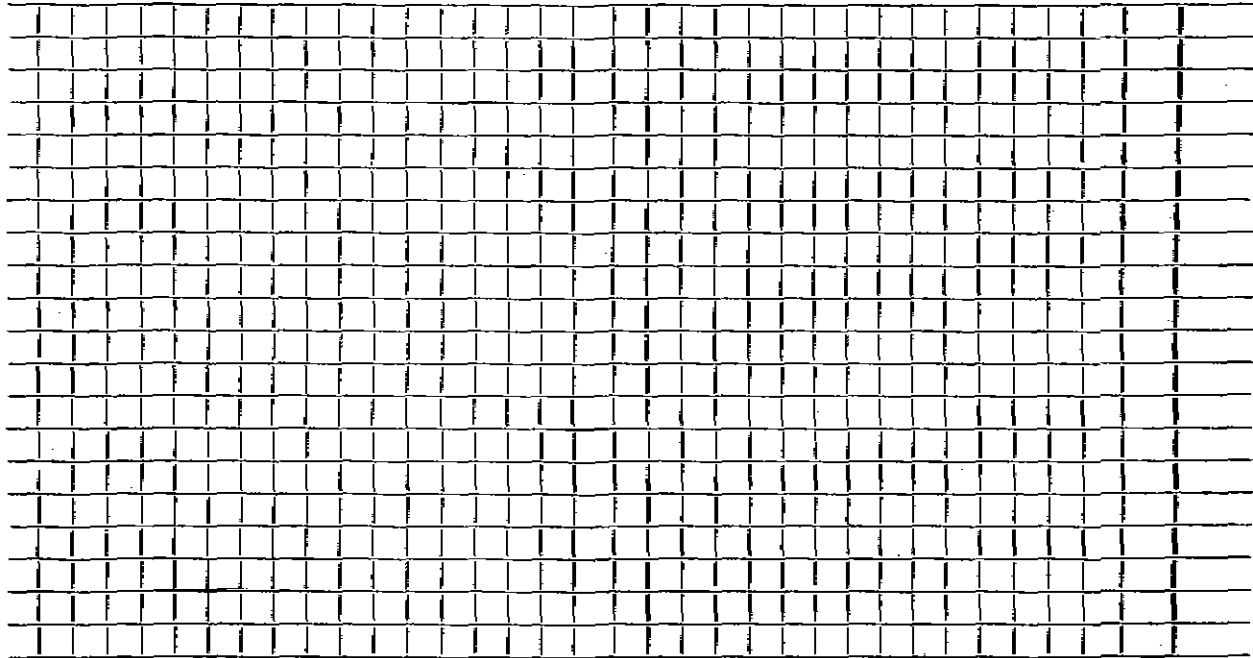

Connection made in Street. Work completed

Remarks:
.....
.....