

Name Joseph LeBlanc

Service No. 143

Address 11 Nichols Road

11 Nichols Rd.

Location

Kind of Pipe

Size 6"

Size of Main 8"

~~Repair Work~~—New Service

WO #7591

Location

Comm 1-14-63


Date	Material	Amount	Total	Date	Amount
-19-62	Labor 8.36			9-10-62	Deposit 250.00
-20-62	" 16.72			1-14-63	Refund 90.33
-31-62	" 63.26	88.34			159.67
	10% O.H.	8.83	97.17		
	25' 6" Transite pipe @.82		20.50		
	2 hrs. Town Shovel @6.50		13.00		
	3 hrs. Trucking @3.00		9.00		
	Spring Loam & Seed		20.00		
			159.67		

DATE \_\_\_\_\_

TOWN OF LEXINGTON — BOARD OF PUBLIC WORKS

SEWER DIVISION

Sketch of Service Here //

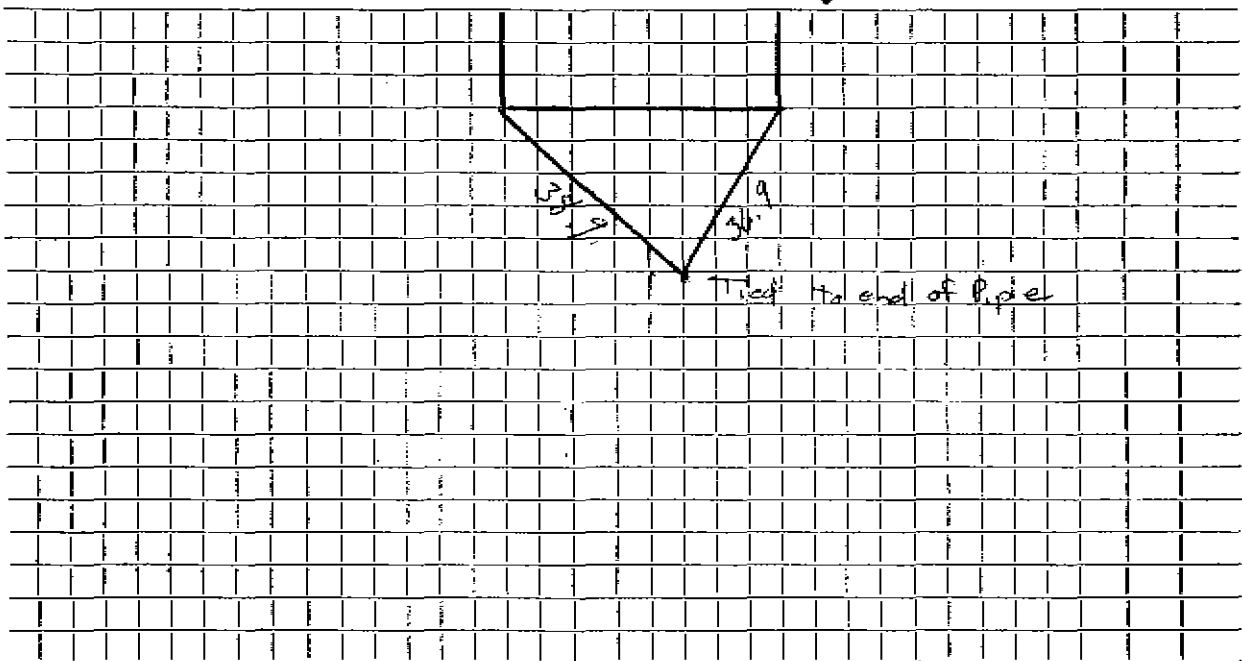

Connection made in ..... Street. Work completed .....

Remarks: .....  
.....  
.....