


DATE _____

TOWN OF LEXINGTON — BOARD OF PUBLIC WORKS
SEWER DIVISION

Sketch of Service Here

14

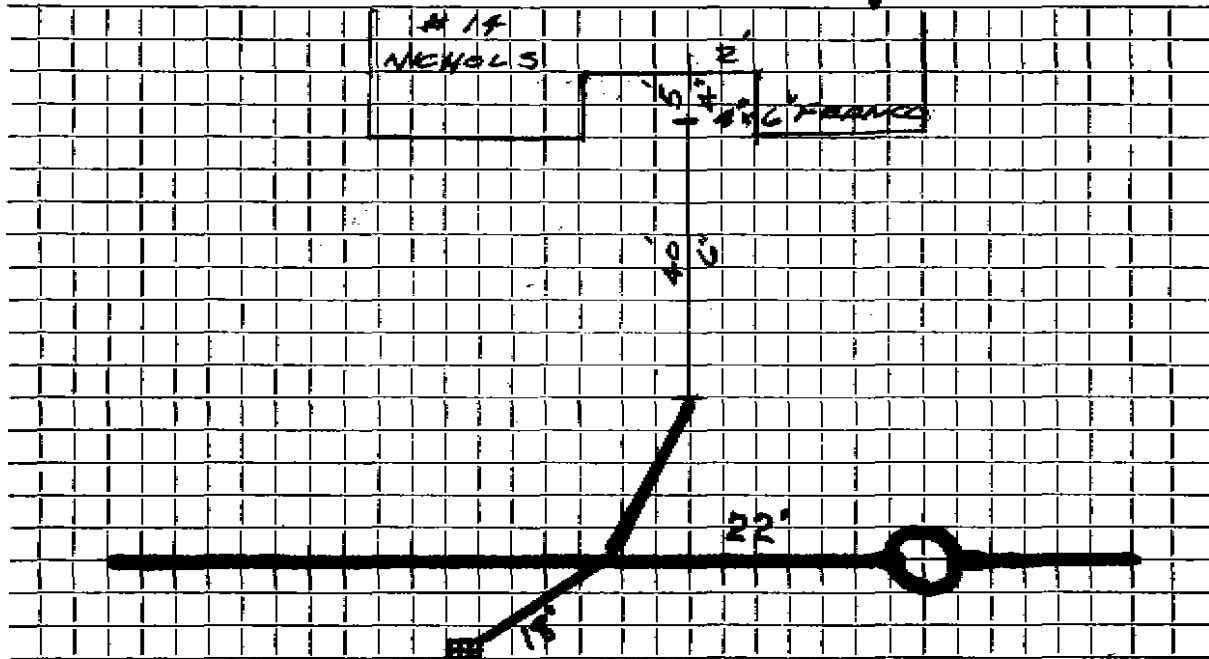

Connection made in NICHOLS RD. Street. Work completed

Remarks: