

Name **George P. Bennett**

Service No. **45**

Address **15 Nichols Road**

15 Nichols Rd.

Location

Kind of Pipe

Size **6"**

Size of Main **8"**

~~Repair~~ **New Service**

No # **8670**


Location **JUN 29 1964**

Date	Material	Amount	Total	Date	Amount
2-64	Labor	58 89		4-8-64	250 00
	10% O.H.	5 89	64 78	6-29-64	130 53
30'	6" Transite pipe @.82		24 60		119 47
1	Bag Cement		1 50		
1	11 1/4" Transite Bend		4 09		
4	Yards Loam @3.00		12 00		
1	Hr. Town Shovel @6.50		6 50		
2	Hrs. Trucking @3.00		6 00		
			<u>119 47</u>		

TOWN OF LEXINGTON — BOARD OF PUBLIC WORKS
 DATE _____

SEWER DIVISION

Sketch of Service Here **15**

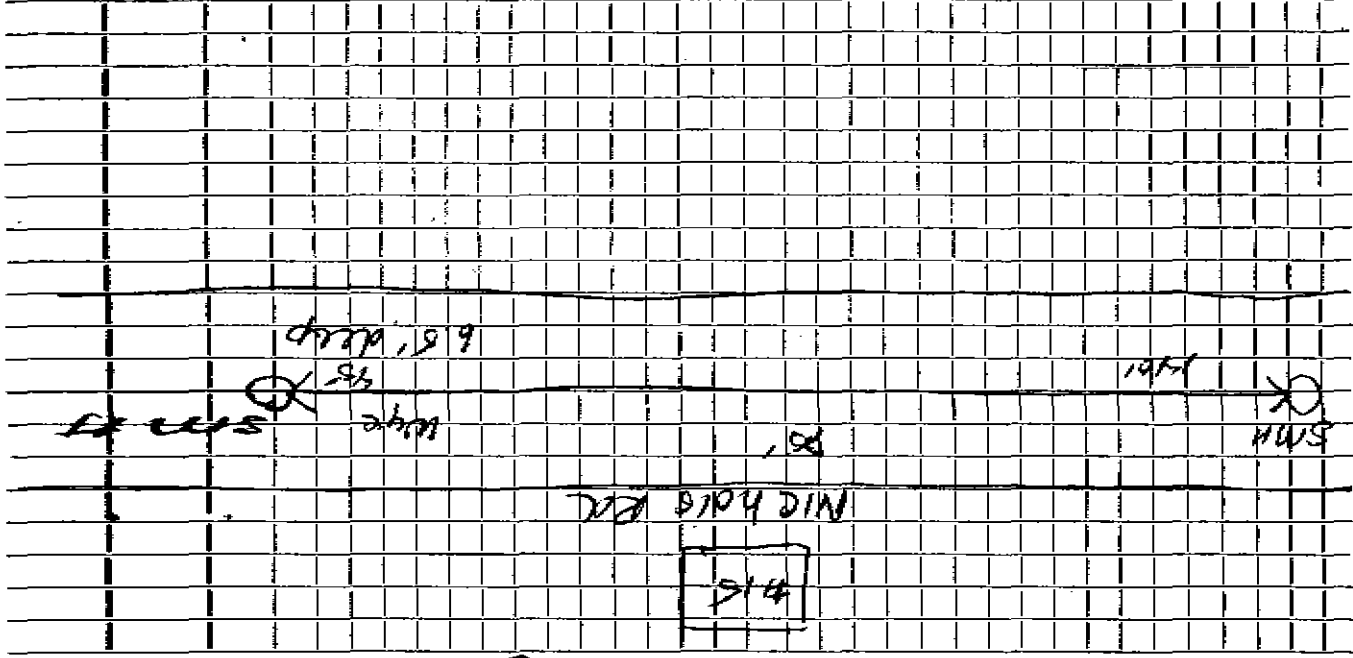

Work completed

Street

Connection made in

Remarks: