

Name **Lawrence W. Sharpe**Service No. **64**Address **21 Nichols Road****21 Nichols Rd.**

Location

**Comm. 10-29-56**

Kind of Pipe

Size **6"**Size of Main **8"**Repair: ~~Renewal~~ — **New Service**

Location

Date	Material	Amount	Total	Date	Amount
7/1/56	Labor	99 62		5-31-56	Deposit
	"	73 23	172 85	1-9-56	Paid
	10% overhead	17 29	190 14		
	70' 6" Sewer pipe @.455		31 85		
	Joint compound		4 20		
	4 sticks Dynamite @.25		1 00		
	4 caps @ .1775		71		
	6hrs. town shovel @ 6.00		36 00		
	1hr trucking		3 00		
	1hr Roger Trailer @ 3.00		3 00		
	2 hrs compressor @1.75		3 50		
	Labor		273 40		
					Bill sent 11-5-56

**TOWN OF LEXINGTON—DEPT. OF PUBLIC WORKS**  
**SEWER DIVISION**

DATE.....

NO.....


The undersigned applies for the construction of a particular sewer connecting No.....  
Street and hereby agrees to comply with the Rules and Regulations governing the construction and use of Particular  
Sewers, as now or at any future time established by the Board of Selectmen.

Am't of estimate \$.....

Am't Paid \$.....

..... Owner

**Sketch of Service Here**

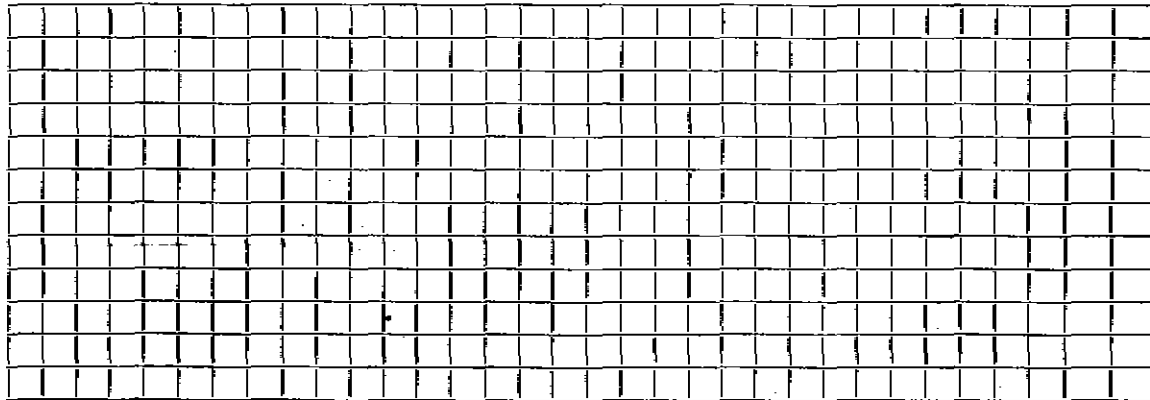

Connection made in..... Street. Work completed..... 19..

Remarks: