

Name **Donald K. Irwin**

Service No. **27**

Address **6 Nichols Road**

6 Nichols Rd.

Location

Kind of Pipe

Size **6"**

Size of Main **8"**

~~Repair Expense~~ **New Service**

COM.6-13-55

Location

Date	Material	Amount	Total	Date	Amount
4/28/55	Labor	10 10		3-30-55	125 00
4/29/55	"	24 91	35 01	6-13-55	(10 01)
	10% overhead		3 50		114 99
	46' - 6" sewer pipe @ .32		14 72		
	joint compound		2 76		
	7 2/3 hrs. Littlefield shovel @	7.50	57 50		
	2 hrs. trucking @ .75		1 50		
			<u>114 99</u>		
	Labor				

TOWN OF LEXINGTON—DEPT. OF PUBLIC WORKS
SEWER DIVISION

DATE.....

NO.....


The undersigned applies for the construction of a particular sewer connecting No.....
Street and hereby agrees to comply with the Rules and Regulations governing the construction and use of Particular
Sewers, as now or at any future time established by the Board of Selectmen.

Am't of estimate \$.....

Am't Paid \$.....

..... Owner

Sketch of Service Here

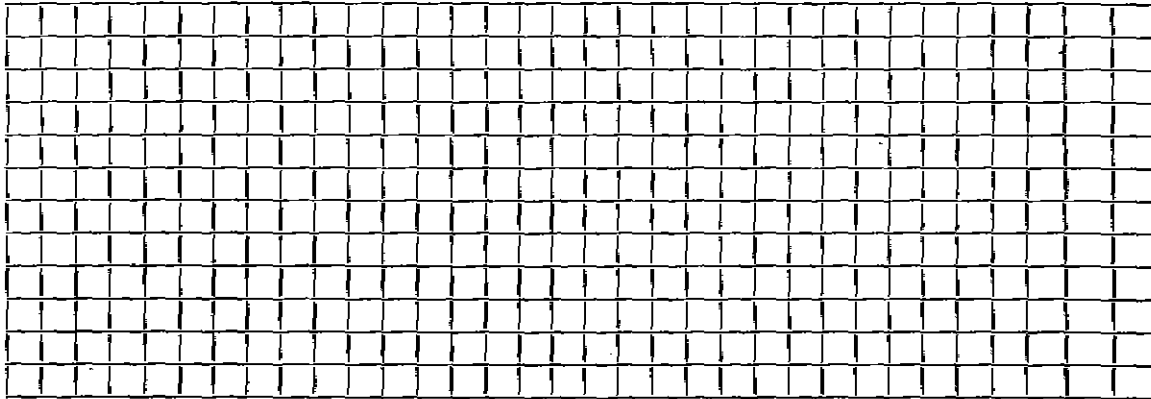

Connection made in..... Street.

Work completed.....19..

Remarks: