

Name

Service No.

Address 7 NICHOLS RD

7 Nichols Rd.

Location

Kind of Pipe

Size 6"

Size of Main 8"

Repair—Renewal—New Service

Location

Date	Material	Amount	Total	Date	Amount
12-21-59	36' 6" Transite				
				7-30-75	
				22' 6" Transite	
				1 6" X 8" Wye	


DATE _____

TOWN OF LEXINGTON — BOARD OF PUBLIC WORKS

SEWER DIVISION

7 Sketch of Service Here

7 Nichols RD

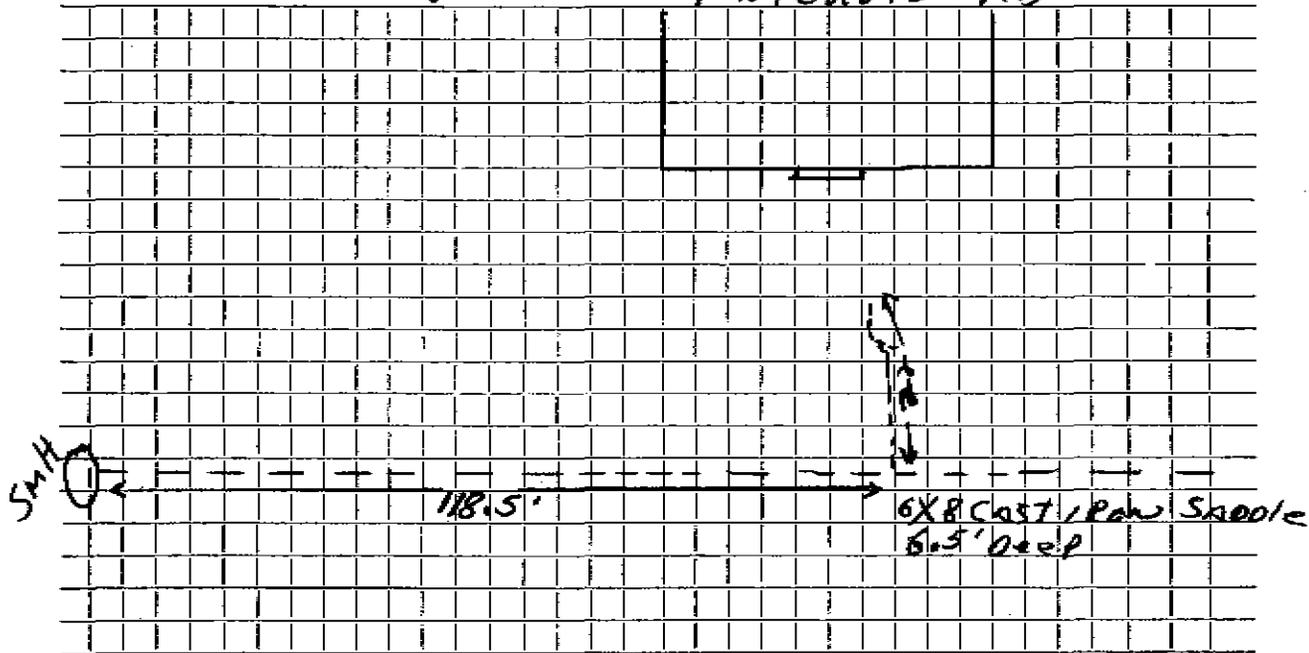

Connection made in 7 Nichols RD Street. Work completed 7/30/75

Remarks: Replaced 77' of clay 6" pipe with 77' of 6" TRANSITE pipe from sewer
main to property line