

Name Jenkins Realty

Service No. 177

Address 1 Nickerson Road

JUN 18 1973

Lot #227 Vacant / Nickerson Rd.

Location

Kind of Pipe Size 6" Size of Main 8"

REPURPOSED - New Service DePolice #2188

Location


Date	Material	Amount	Total	Date	Amount
Jun 178	20' 6" Pressure pipe @ 7.50		150.00	11-22-72	150.00
				11- -70	
				20' 6" Transite	
				1 6" X 8" Wye	

DATE _____

TOWN OF LEXINGTON — BOARD OF PUBLIC WORKS

SEWER DIVISION

Sketch of Service Here

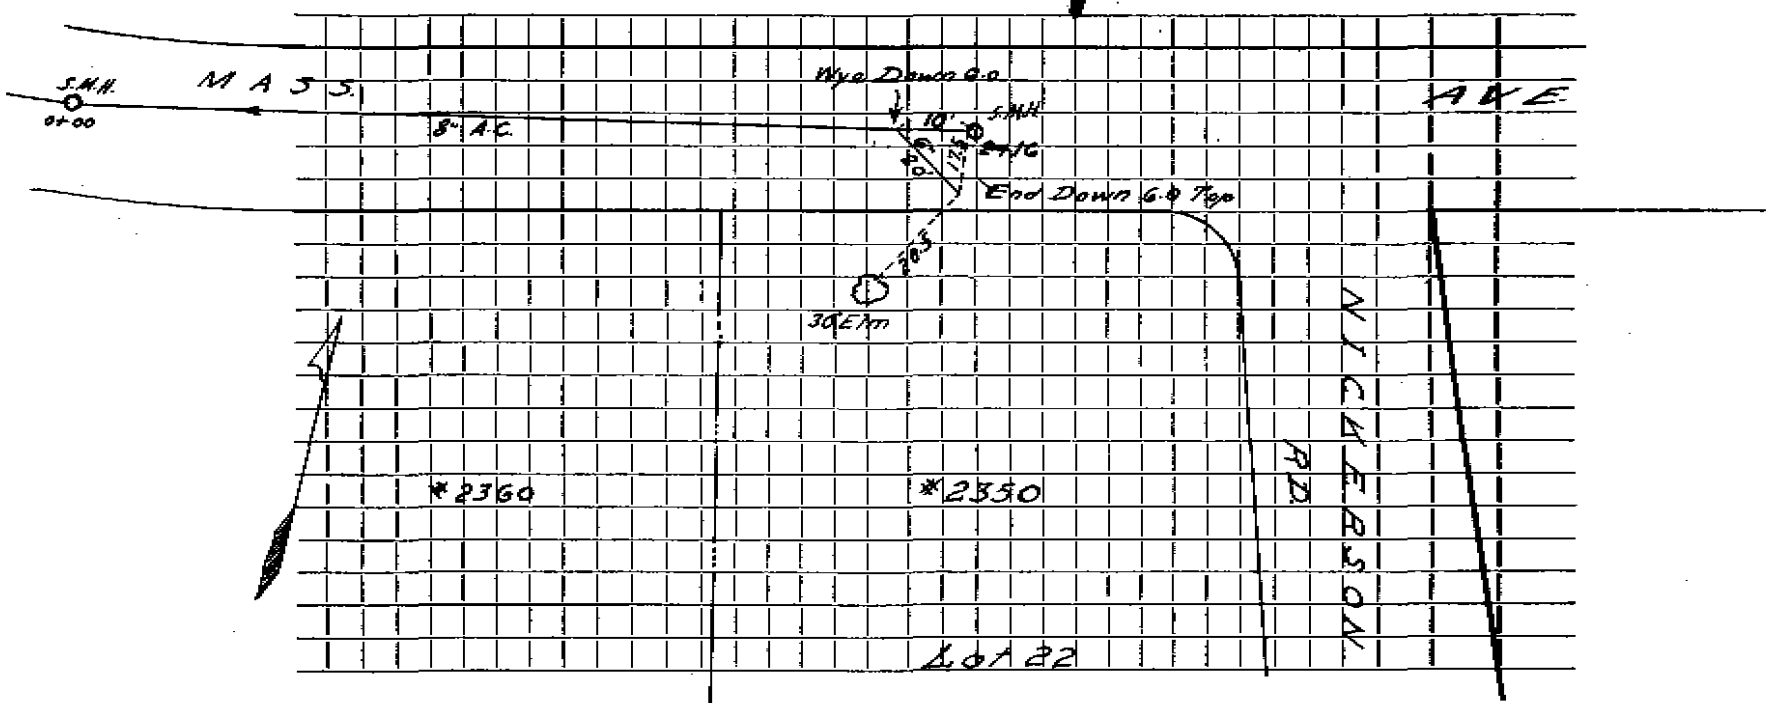

Connection made in Street. Work completed

Remarks:

.....

.....