

Name Jenkins Realty Inc.

Service No.

Address 15 Nickerson Road

15 Nickerson Rd.

Location Lot #17

Kind of Pipe

Size 6"

Size of Main 8"

Repair—Renewal—New Service

DeFliea #1311  
Lucente - Permit #630

Location

Date	Material	Amount	Total	Date	Amount
<del>3-67</del>	<del>30' 6" Transite</del>				
4-69	42' 6" Transite pipe			6-13-67	
	10' 4" Cast Iron Pipe			30' 6" Transite	
				1 6" X 8" Wye	


DATE \_\_\_\_\_

TOWN OF LEXINGTON — BOARD OF PUBLIC WORKS

SEWER DIVISION

Sketch of Service Here

15

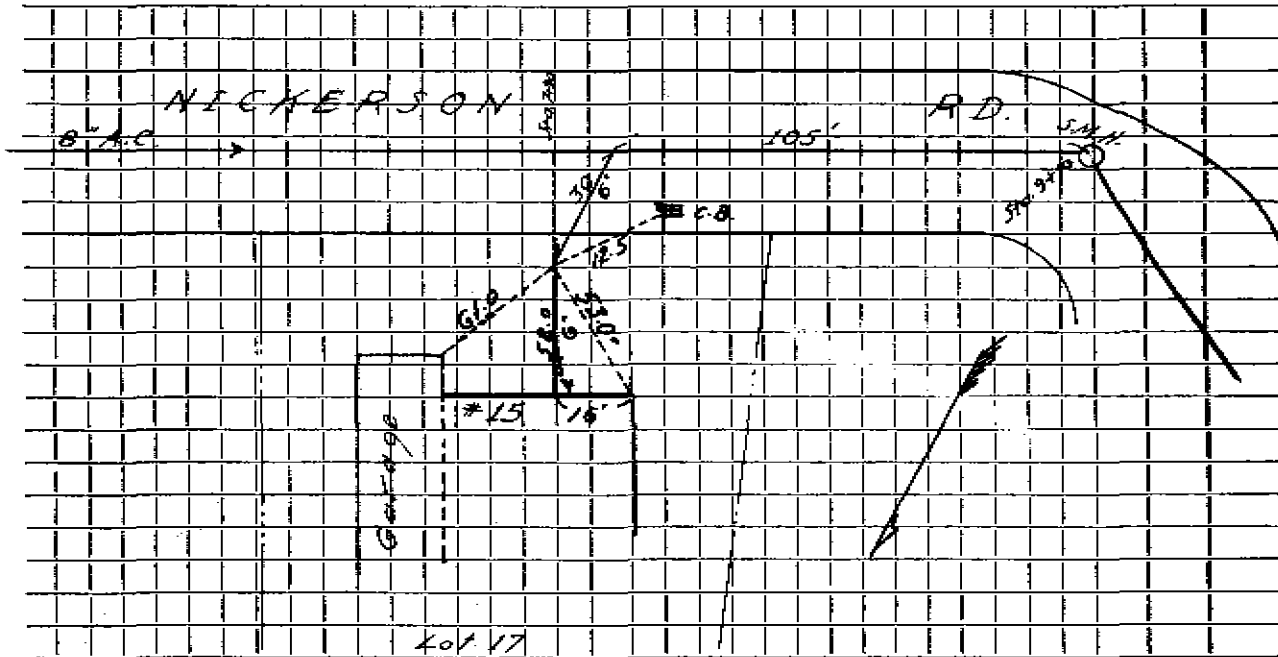

Connection made in ..... Street. Work completed .....

Remarks: .....

.....

.....