

Name Jenkins Realty Inc.

Service No.

Address 18 Nickerson Road

18 Nickerson Rd.

Location Lot #6 A

Kind of Pipe

Size 6"

Size of Main 8"

Repair—Renewal—New Service

Office #1794
Lucente - Permit. 632


Location

Date		Material	Amount	Total	Date		Amount
13/67	42'	6" Transite					
-23-70	42'	6" Transite pipe			6-13-67		
	10'	4" Cast Iron pipe				42' 6" Transite	
						1 6"x8" Wye	

DATE _____

TOWN OF LEXINGTON — BOARD OF PUBLIC WORKS
SEWER DIVISION

Sketch of Service Here **18**

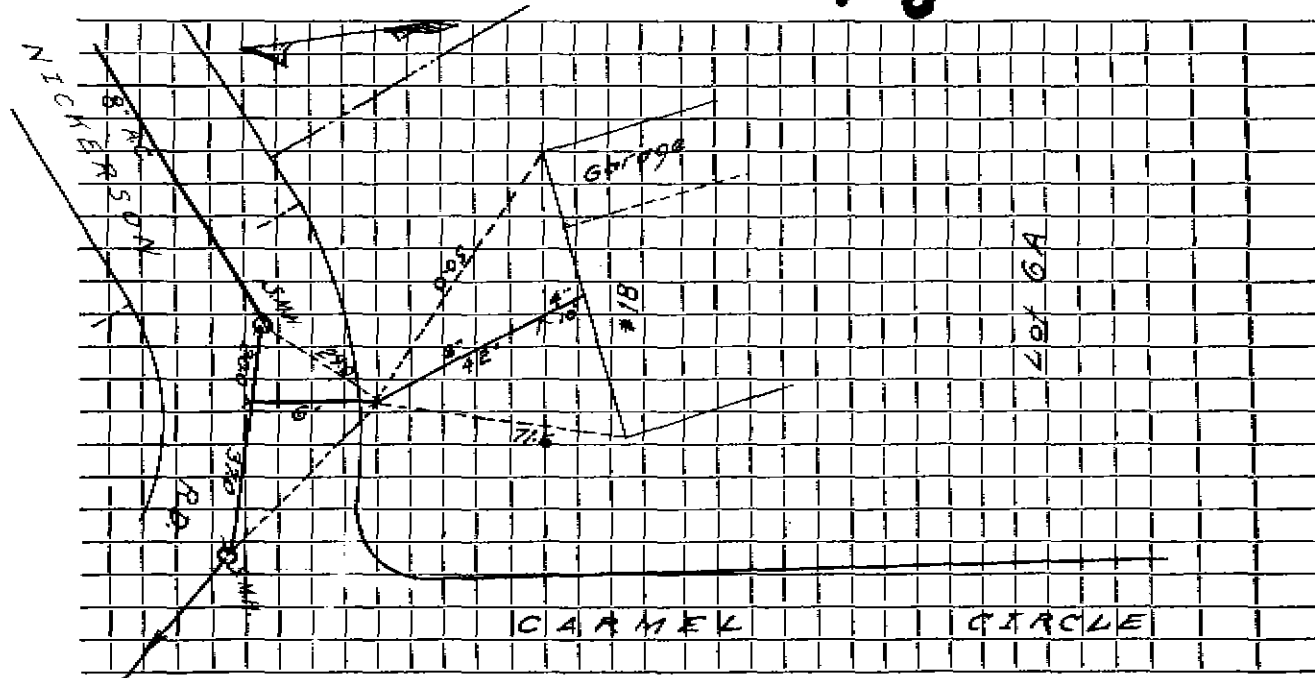

Connection made in Street. Work completed

Remarks:

.....

.....