

Name

Service No.

Address **2 Nickerson Road**

2 Nickerson Rd.

Location

Kind of Pipe

Size **6"**

Size of Main **8"**

Repair—Renewal—New Service

Location


Date		Material	Amount	Total	Date		Amount
12-27-72	48'	6" Transite					
	10'	4" Cast Iron					
						17' 6" Transite	

TOWN OF LEXINGTON — BOARD OF PUBLIC WORKS

SEWER DIVISION

Sketch of Service Here

2

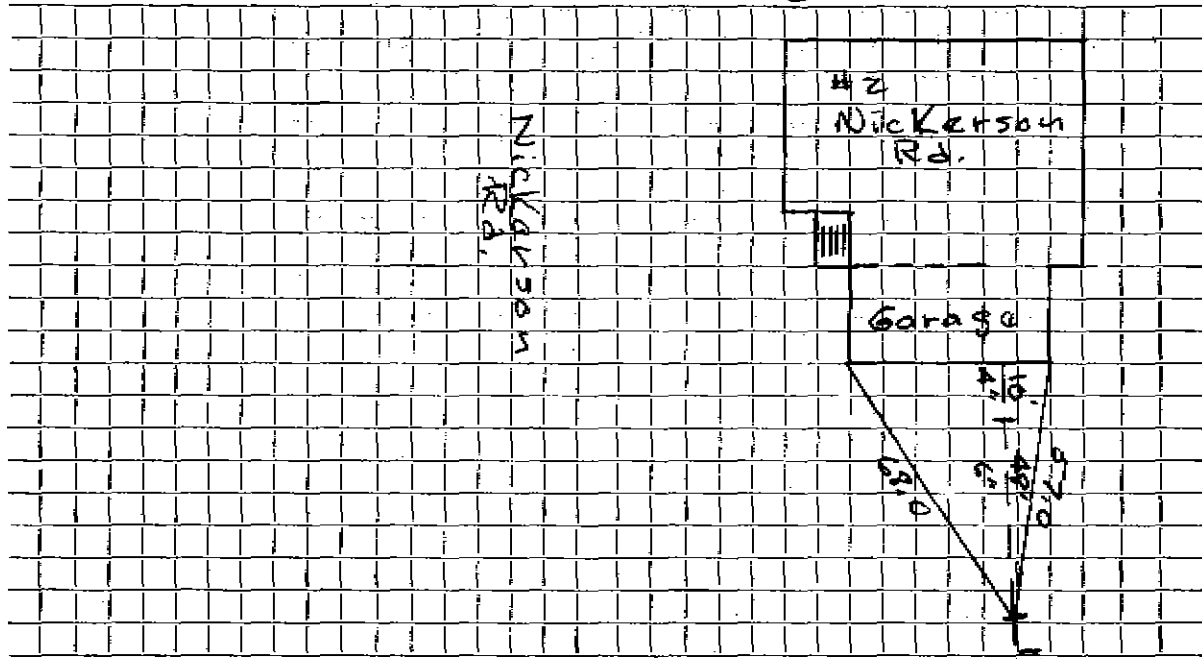

Connection made in Mass. Ave. Street. Work completed 05MH Mass. Ave.

Remarks:
.....
.....