

Name Jenkins Realty

Service No.

Address 23 Nickerson Road

23 Nickerson Rd.

Location Lot #16

Kind of Pipe

Size 6"

Size of Main 8"

Repair—Renewal—New Service

DeFlice #1383

J.M. Lucente Co. - Permit #635

Location


Date	Material	Amount	Total	Date	Amount
1-13-67	33' 6" Transite				
31-69	37' 6" Transite pipe			6-13-67	
	10' 4" Cast Iron pipe				
					33' 6" Transite
					1 6" X 8" Wye

TOWN OF LEXINGTON — BOARD OF PUBLIC WORKS

SEWER DIVISION

Sketch of Service Here

23

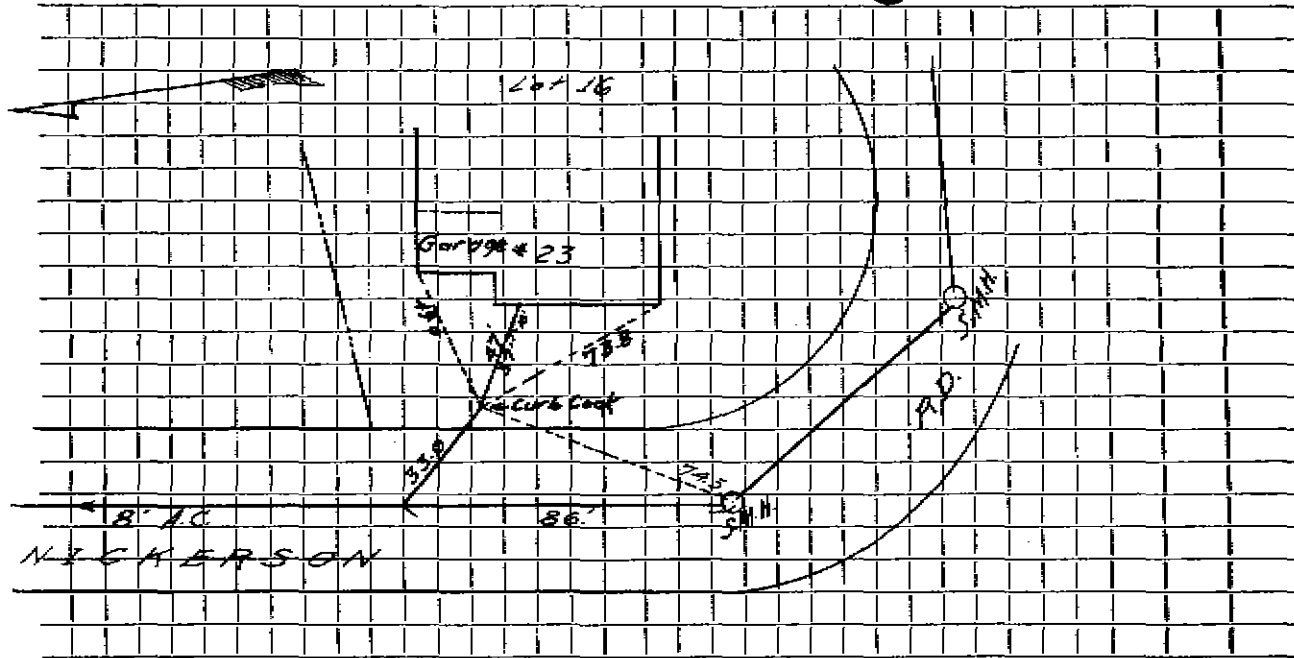

Connection made in Street. Work completed

Remarks:

.....

.....