

Name

Service No.

Address 24 Nickerson Road

24 Nickerson Rd.

Location Lot #3

Kind of Pipe

Size 6"

Size of Main 8"

Repair—Renewal—New Service

Incent Permit # 636

Location


Date	Material	Amount	Total	Date	Amount
17/67	32' 6" Transite				
				6-17-67	
				32' 6" Transite	
				1 6" x 8" Wye	

DATE _____

TOWN OF LEXINGTON — BOARD OF PUBLIC WORKS

SEWER DIVISION

Sketch of Service Here **24**

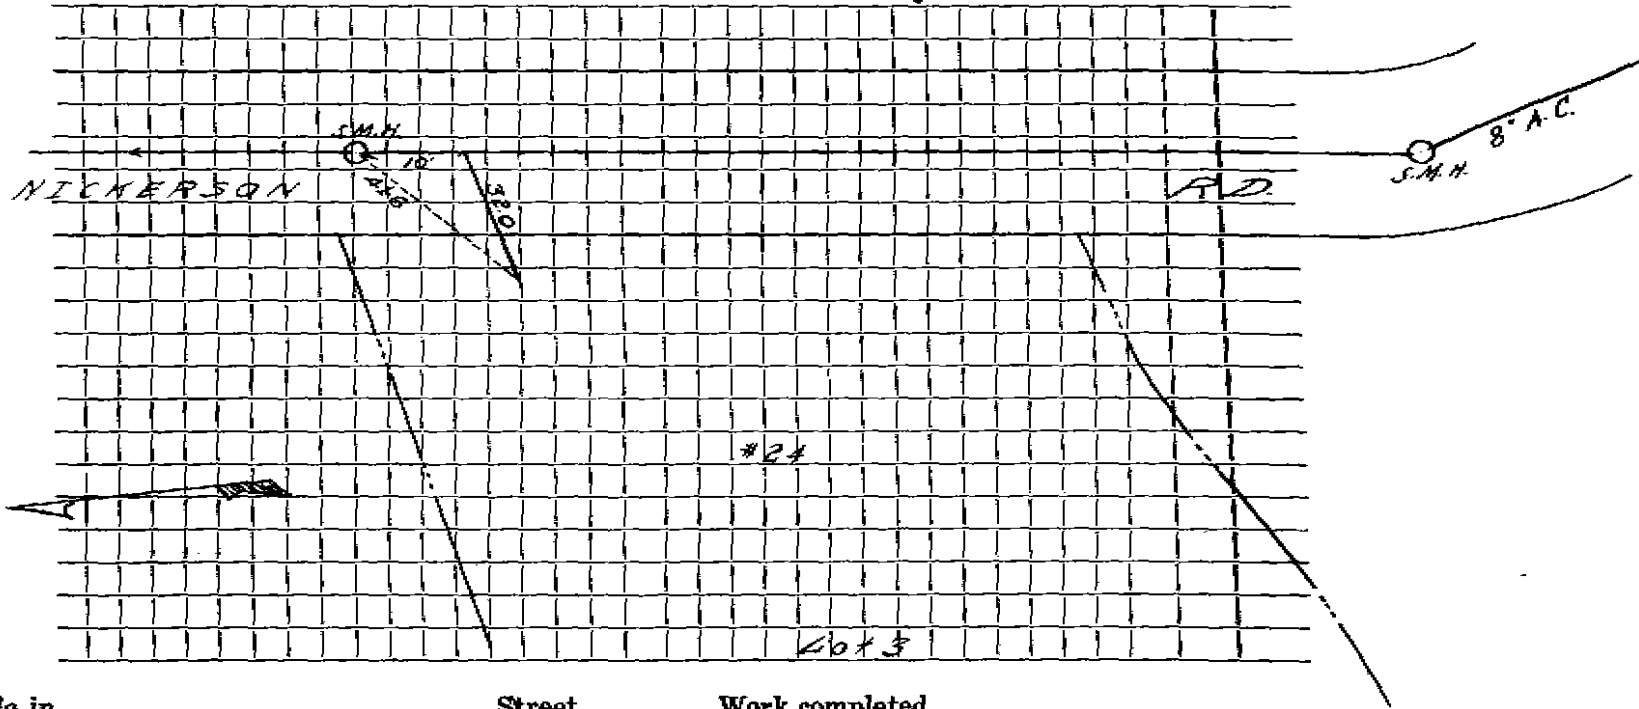

Connection made in Street. Work completed

Remarks:

.....

.....