

Name Jenkins Realty

Service No.

Address 3 Nickerson Road

3 Nickerson Rd.

Location

Kind of Pipe

Size 6"

Size of Main 8"

Repair—Renewal—New Service DeFlice #1812

Location

Date		Material	Amount		Total		Date		Amount	
4-18-71	5'	6" Transite pipe								
	16'	4" Cast Iron pipe								


DATE _____

TOWN OF LEXINGTON — BOARD OF PUBLIC WORKS

SEWER DIVISION

Sketch of Service Here

3

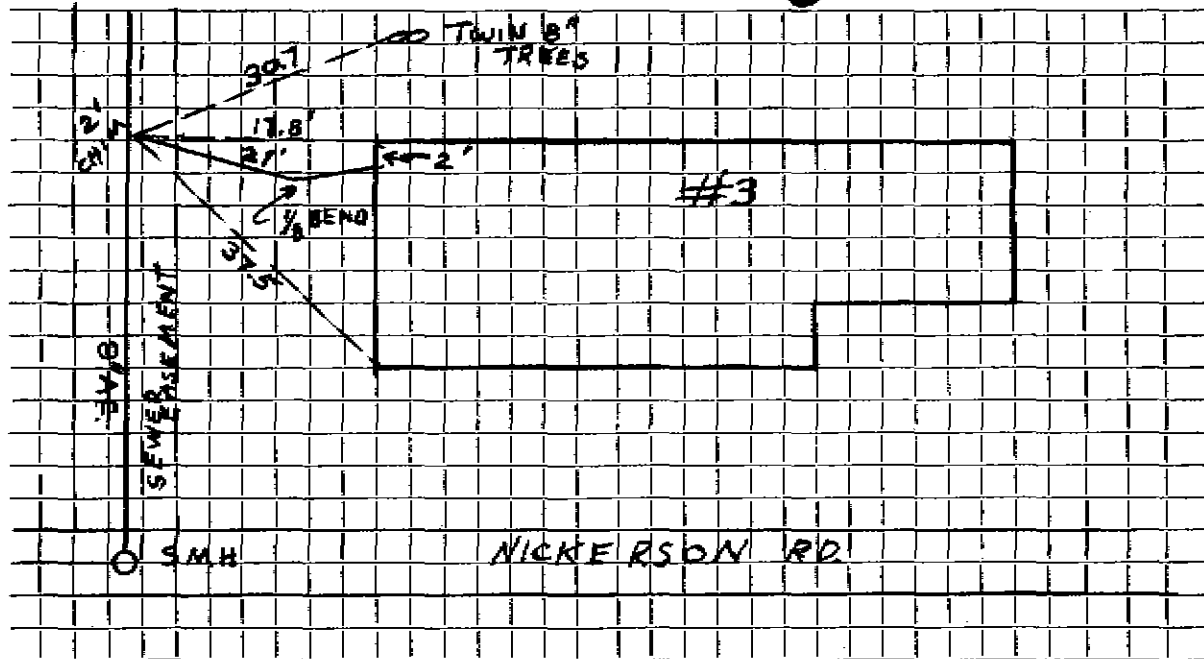

Connection made in Street. Work completed

Remarks:

.....

.....