

Name Joseph C. Steinkrauss

Service No. 149

Address 16 Normandy Road

16 Normandy Rd.

Location

Kind of Pipe Russell Sibley Permit #470

Size 6"

Size of Main 8"

Repair—Renewal—New Service

Location

SEP 27 1965


Date	Material	Amount	Total	Date	Amount
15-65	20' 6" Transite pipe @	5.00	100.00	8-27-65	100.00
					Deposit
-9-65	25' 6" Transite pipe			2-15-65	
				20' 6" Transite	
				1 6" X 8" Wye	

DATE _____

TOWN OF LEXINGTON — BOARD OF PUBLIC WORKS
SEWER DIVISION

Sketch of Service Here

16

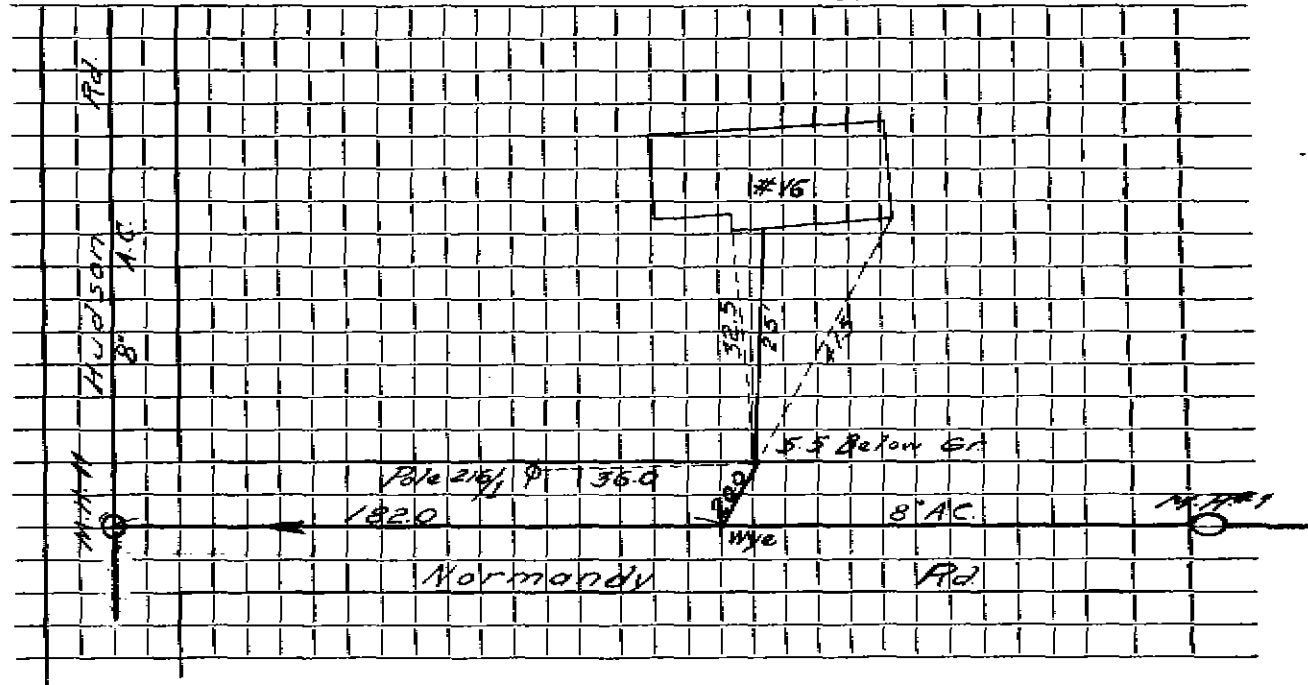

Connection made in Street. Work completed

Remarks:
.....
.....