




DATE \_\_\_\_\_

**TOWN OF LEXINGTON — BOARD OF PUBLIC WORKS**  
**SEWER DIVISION**

Sketch of Service Here

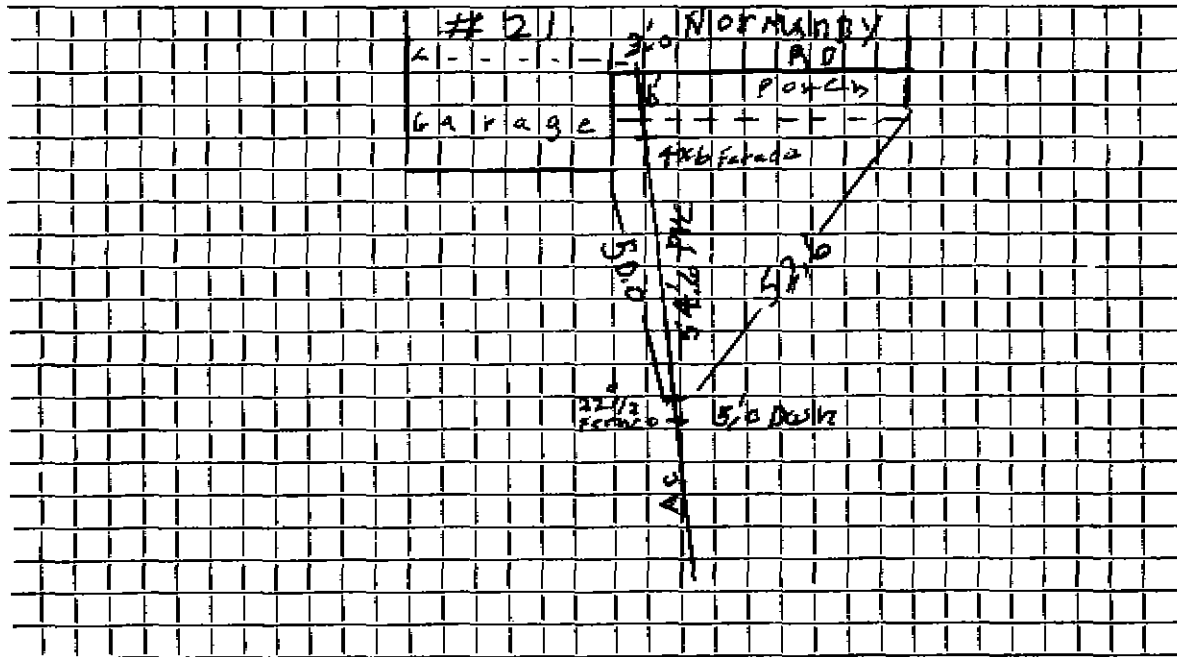

Connection made in ..... Street. Work completed 8/5/08 - J. McLaughlin...

Remarks: old card shows - 6" - 11 1/4" bend and 11 1/4" Elbow. ....