


DATE _____

TOWN OF LEXINGTON — BOARD OF PUBLIC WORKS SEWER DIVISION

Sketch of Service Here

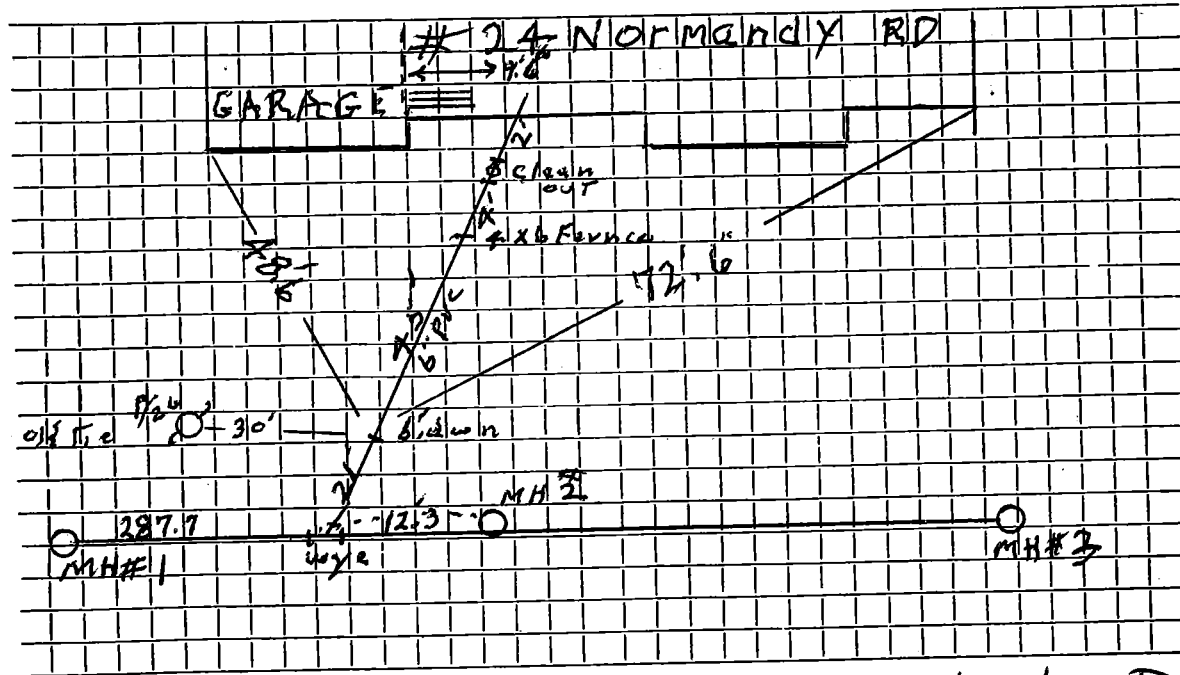

Connection made in Street.

Work completed 11/10/11 J. McLaughlin

Remarks:
.....
.....