

Name John R. Gurrier, Jr.

Service No. 113

Address 25 Normandy Road

25 Normandy Rd.

Location

Kind of Pipe

Size 6"

Size of Main 8"

~~Basic Service~~ New Service Russell Sibley Permit #402

Location AUG 9 1965


Date	Material	Amount	Total	Date	Amount
<del>65</del> 20'	<del>6" Transite pipe @5.00</del>		100.00	7-29-65	Deposit 100.00
65 24'	6" Transite pipe			2-15-65	20' 6" Transite 1 6" X 8" Wye
30-99	Repair made under guts main 2 - 6x6 AC to PVC Francos 5' - 6" PVC Pipe				

DATE \_\_\_\_\_

TOWN OF LEXINGTON — BOARD OF PUBLIC WORKS  
SEWER DIVISION

Sketch of Service Here

25

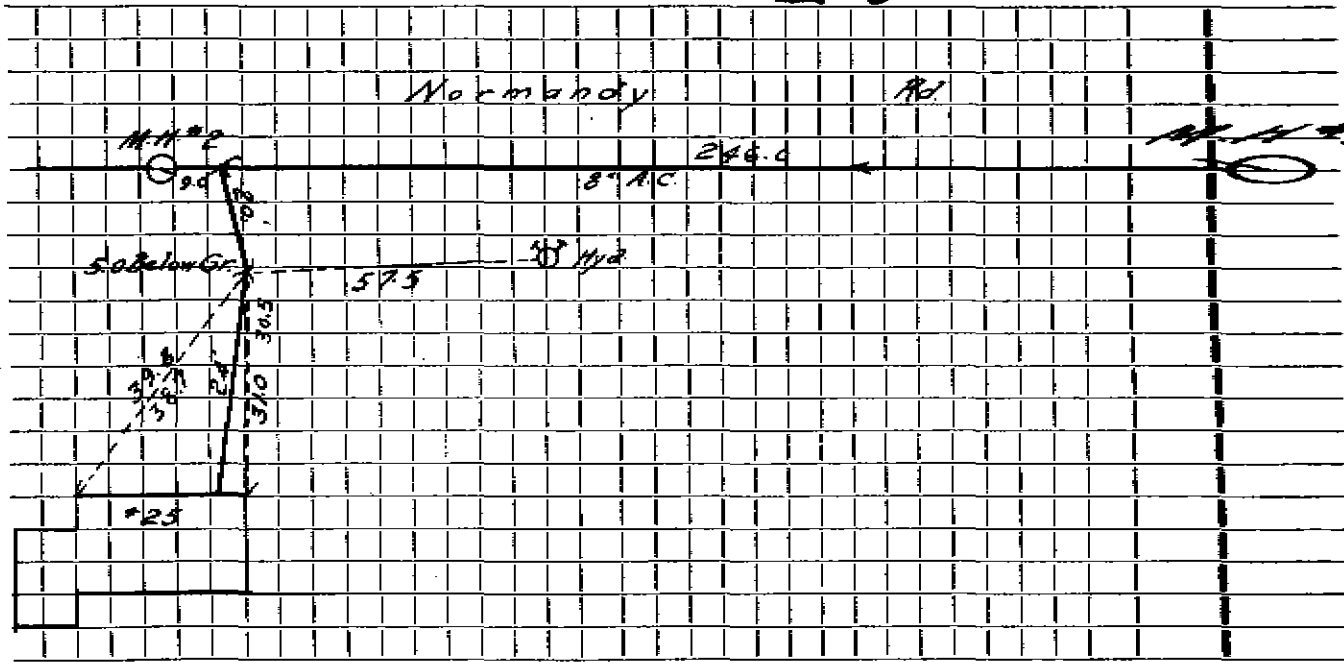

Connection made in ..... Street. Work completed .....

Remarks: .....  
.....  
.....