

Name **Morton Madoff**

Service No. **188**

Address **27 Normandy Road**

Location

27 Normandy Rd.

Kind of Pipe **Parmit #A36**

Size **6"**

Size of Main **8"**

~~Repair~~ **New Service** **Russell Sibley**

Location

DEC 31 1965

| Date | Material | Amount | Total | Date | Amount |
|---------------------|-----------------------------------|--------|--------|---------|-----------------|
| 5-65 25' | 6" Transite pipe @5.00 | | 125.00 | 10-8-65 | Deposit 125.00 |
| 18-65 | 30' 6" Transite pipe | | | 2-15-65 | |
| | | | | | 25' 6" Transite |
| | | | | | 1 6" X 8" Wye |


DATE _____

TOWN OF LEXINGTON — BOARD OF PUBLIC WORKS

SEWER DIVISION

Sketch of Service Here

27

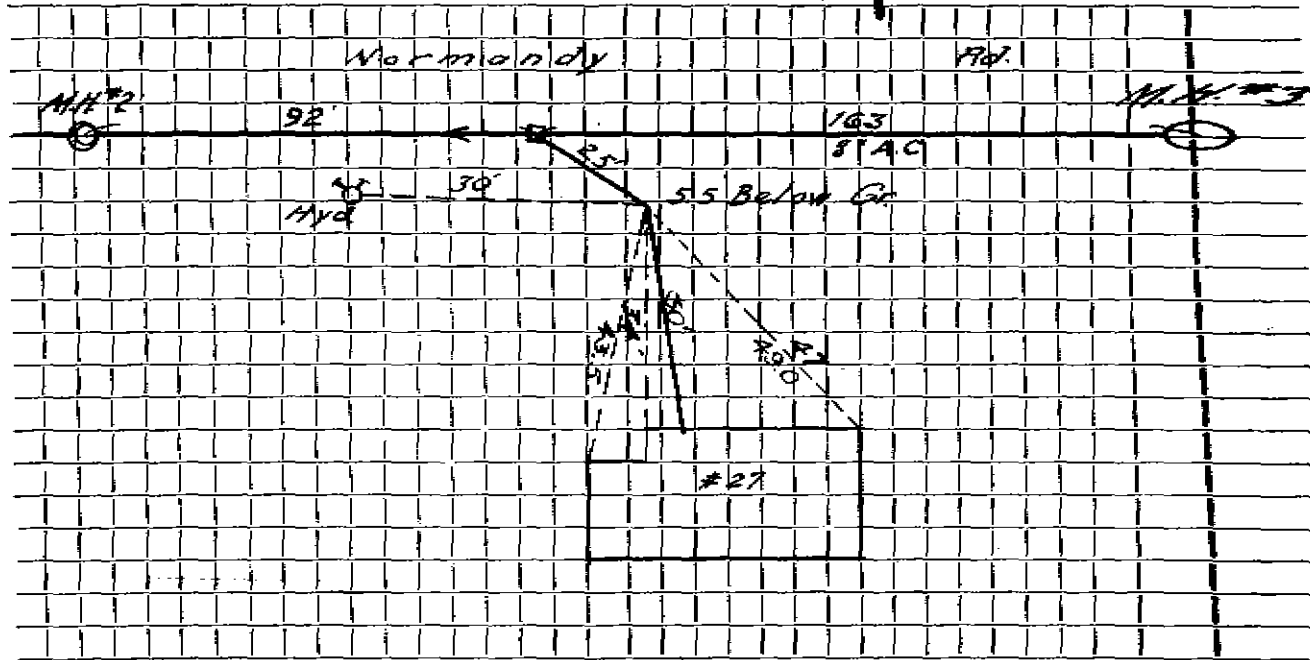

Connection made in Street. Work completed

Remarks:

.....

.....