

Name **Alexander Bell**

Service No. 29

Address **28 Normandy Road**

**28 Normandy Rd.**

Location

Kind of Pipe

Size **6"**

Size of Main **8"**

Repair—Renewal—New Service

**Lexington Sewerage #1022**


Location **AUG 5 1968**

Date	Material	Amount	Total	Date	Amount
<del>5-65</del>	<del>22' 6" Transite pipe @5.00</del>		110.00	<i>penal charge</i>	
				<del>5-14-68</del>	<del>32' 6" Transite Pipe</del>
					<del>10' 4" Cast Iron</del>
4-65	Relay sewer service			5-8-68	Deposit
	Labor	45 73			121 40
	10% O.H.	4 57	50 30	2-15-65	
20'	6" transite pipe (used same pipe)	<sup>63</sup>	12 60	22'	6" Transite
	10 X 3 Patch		30 00	1	6" X 8" Wye
5	wheelbarrels loan		3 00		
2	Hrs. Town Truck 3.00		6 00		
3	Hrs. Tractor 6.50		19 50		
			<del>105 00</del>		
14-68	32' 6" Transite pipe		121 40		
	10' 4" Cast Iron pipe				

DATE \_\_\_\_\_

TOWN OF LEXINGTON — BOARD OF PUBLIC WORKS  
SEWER DIVISION

Sketch of Service Here **28**

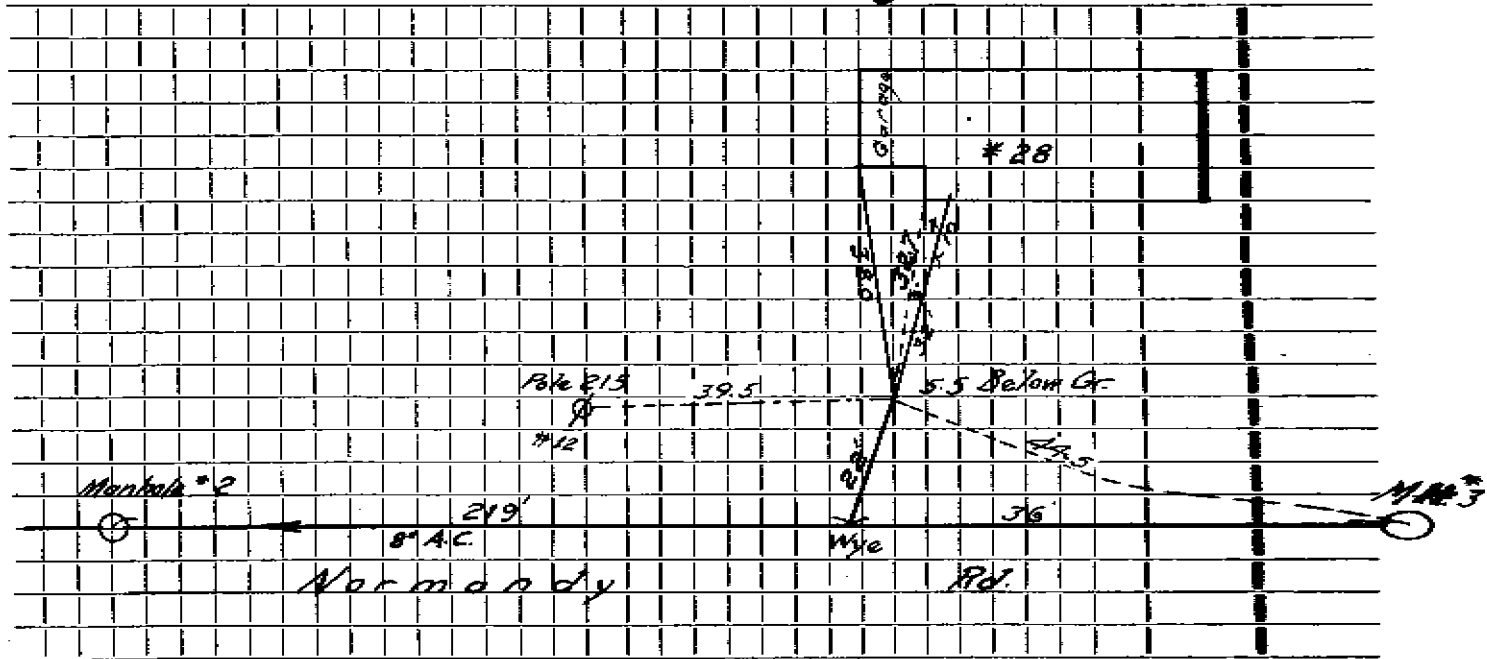

Connection made in ..... Street. Work completed .....

Remarks: .....