




DATE

TOWN OF LEXINGTON — BOARD OF PUBLIC WORKS

SEWER DIVISION

Sketch of Service Here

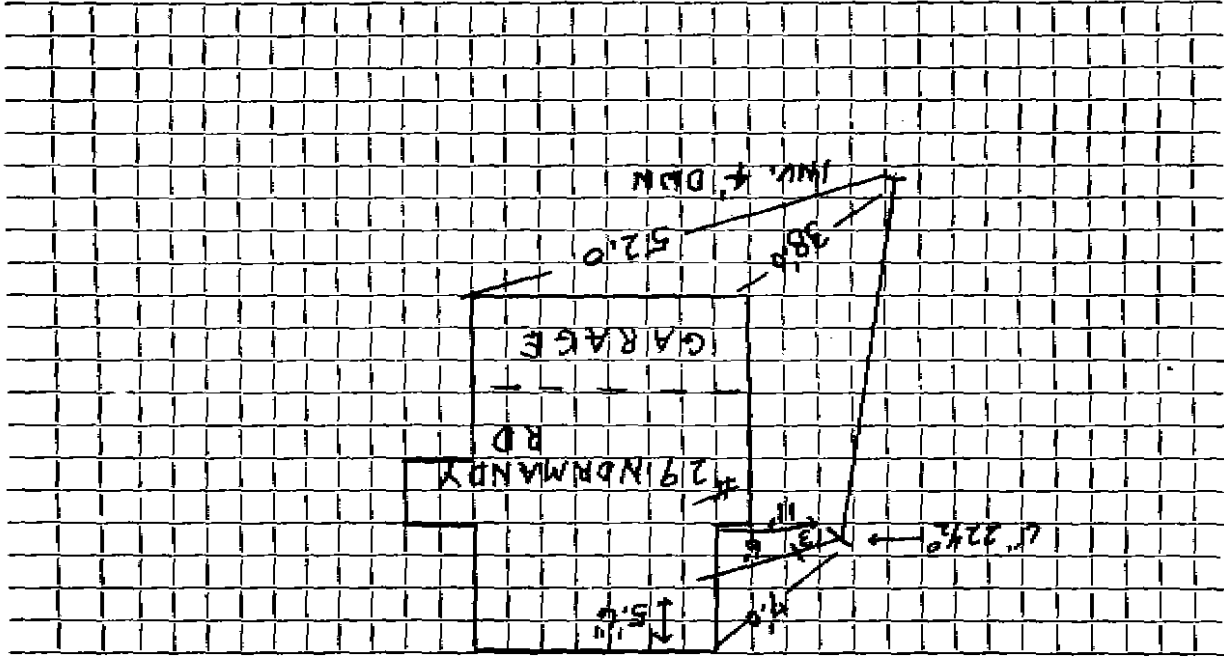

Work completed 12/15/03

Street

Connection made in

Remarks: