

Name **Richard Penta**

Service No. **15**

Address **38 Normandy Road**

JUN 18 1973

38 Normandy Rd.

Location

Kind of Pipe

Size **6"**

Size of Main **8"**

~~XXXXXXXXXXXXXXXXXXXX~~ **New Service Lexington Sewerage Co. #2259**

Location


Date		Material	Amount	Total	Date		Amount
65	22'	6" Transite pipe	@5.00	110.00	1973	Deposit	110.00
9-73	40'	4" Cast Iron pipe					
	30'	6" Transite			2-15-65		
						22' 6" Transite	
						1 6" X 8" Wye	

DATE _____

TOWN OF LEXINGTON — BOARD OF PUBLIC WORKS
SEWER DIVISION

Sketch of Service Here

38

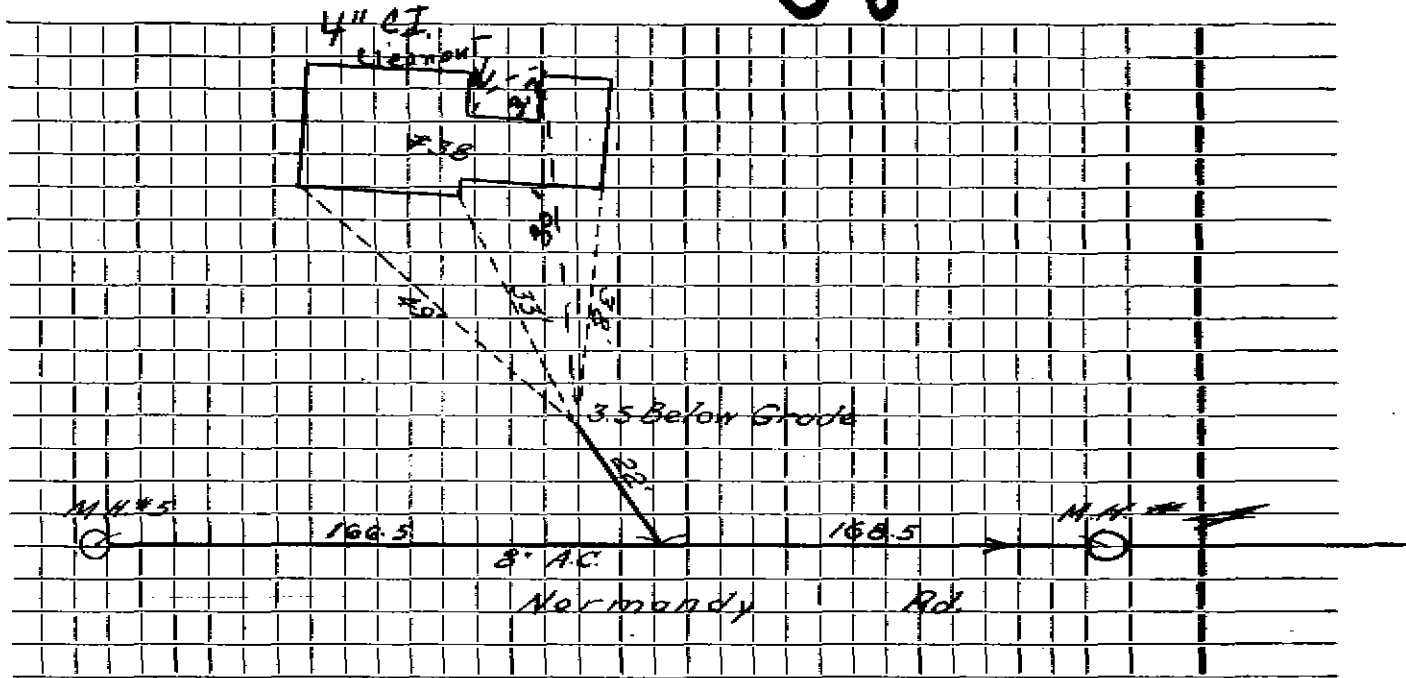

Connection made in Street. Work completed

Remarks:

.....

.....