

Name **George McManis**

Service No. **112**

Address **39 Normandy Road**

**39 Normandy Rd.**

Location

Kind of Pipe

Size **6"**

Size of Main **8"**

Repair ~~Renewal~~ **New Service Valeri Const. Co. Permit #400**

Location **SEP 27 1965**


Date	Material	Amount	Total	Date	Amount
<del>65 18'</del>	<del>6" Transite pipe @5.00</del>		90.00	<del>7-28-65</del>	<del>90.00</del>
9-65 45'	6" Transite pipe			2-15-65	
				18' 6" Transite	
				1 6" X 8" Wye	

DATE \_\_\_\_\_

TOWN OF LEXINGTON — BOARD OF PUBLIC WORKS

SEWER DIVISION

Sketch of Service Here **39**

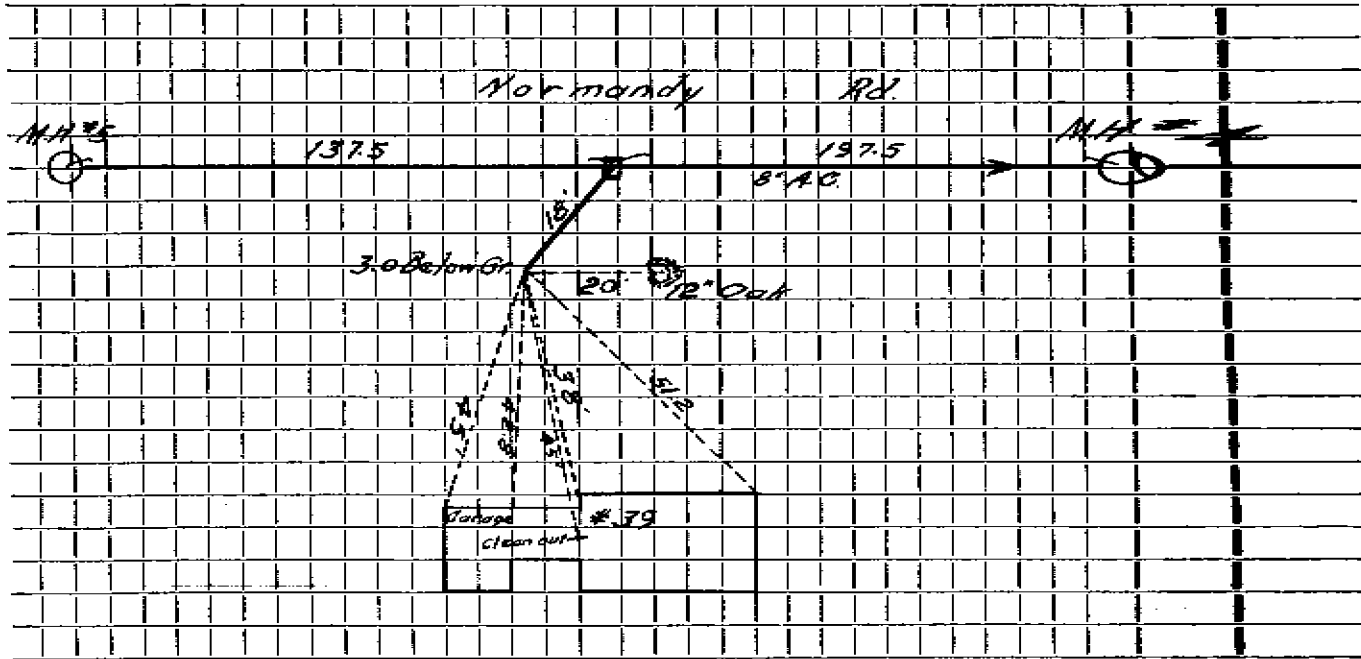

Connection made in ..... Street. Work completed .....

Remarks: .....

.....

.....