


DATE 05/20/24

TOWN OF LEXINGTON — BOARD OF PUBLIC WORKS

SEWER DIVISION  
41 Normandy Rd

Sketch of Service Here

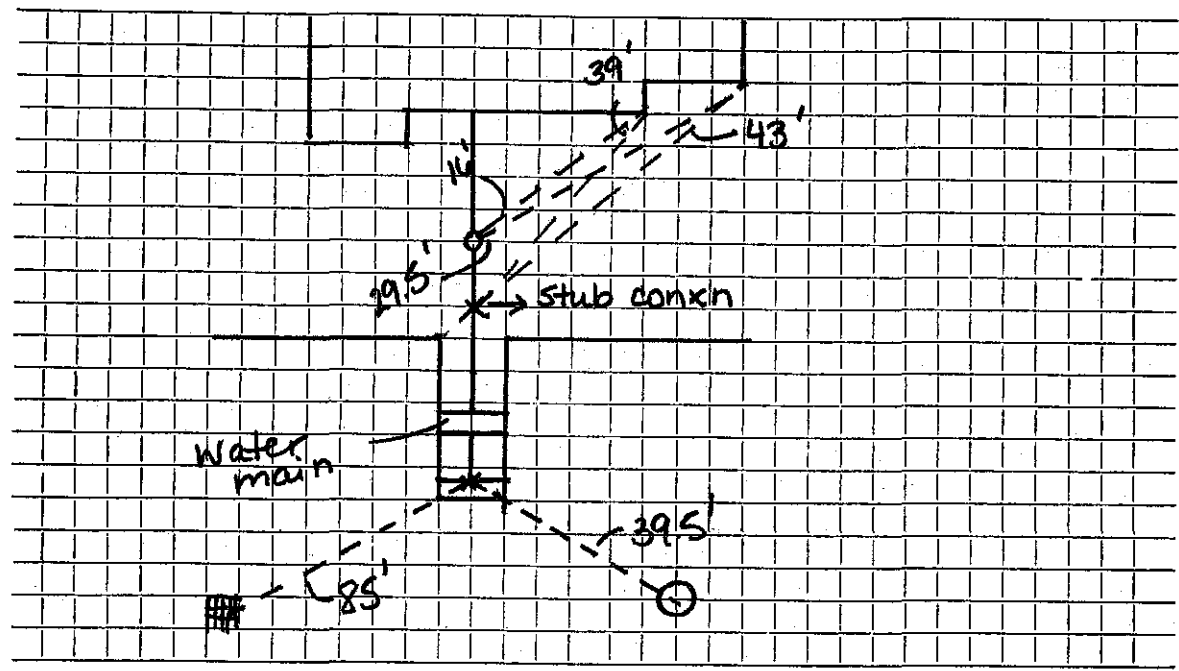

Connection made in Normandy Rd Street.

Work completed JM McLaughlin

Remarks: .....

