


DATE July 2001

TOWN OF LEXINGTON — BOARD OF PUBLIC WORKS
SEWER DIVISION

Sketch of Service Here

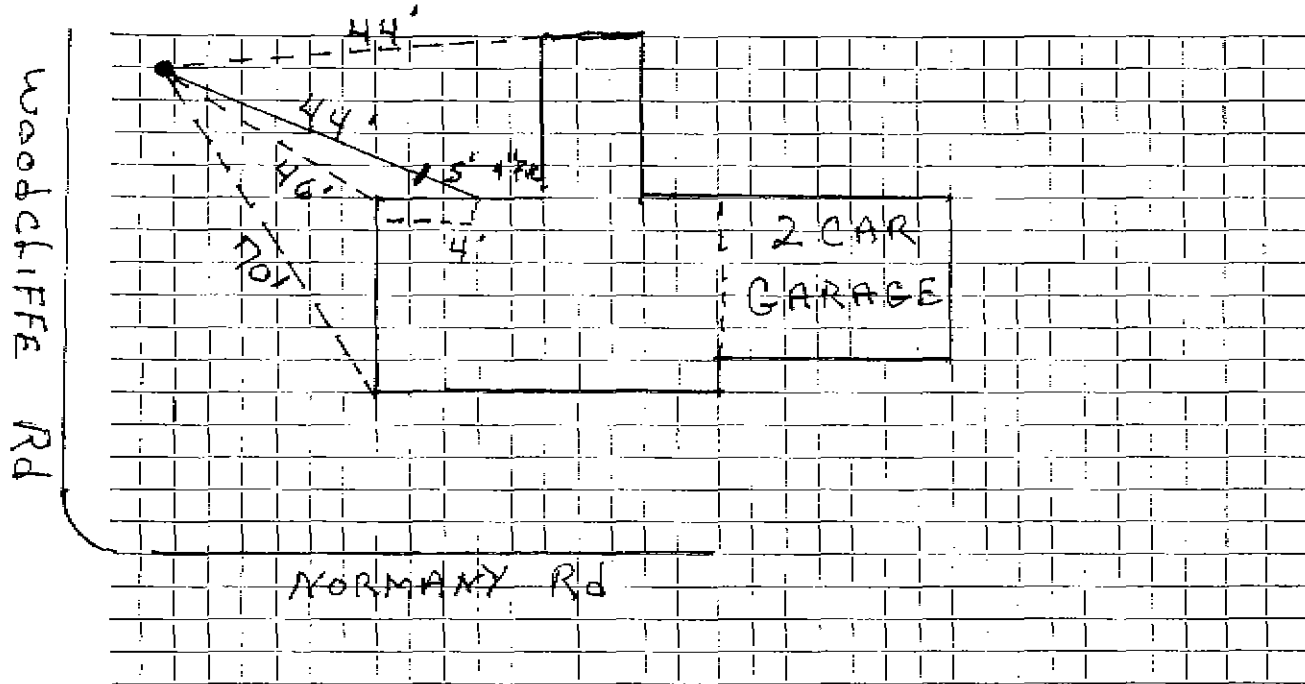

Connection made in WOODCLIFFE Rd Street. Work completed

Remarks: INSTALLED BY J.M. McLAUGHLIN INC.