

Name

Service No.

Address 47 Normandy Road

47 Normandy Rd.

Location

Kind of Pipe

Size 6"

Size of Main 8"

Repair—Renewal—New Service

Location


Date	Material	Amount	Total	Date	Amount
<del>6-2-65</del>	<del>22' 6" 6" P. Transite pipe</del>	55.00	110.00		
				2-16-65	
				22' 6" Transite	
				1 6" x 8" Wye	

DATE \_\_\_\_\_

TOWN OF LEYINGTON — BOARD OF PUBLIC WORKS

SEWER DIVISION

Sketch of Service Here **47**

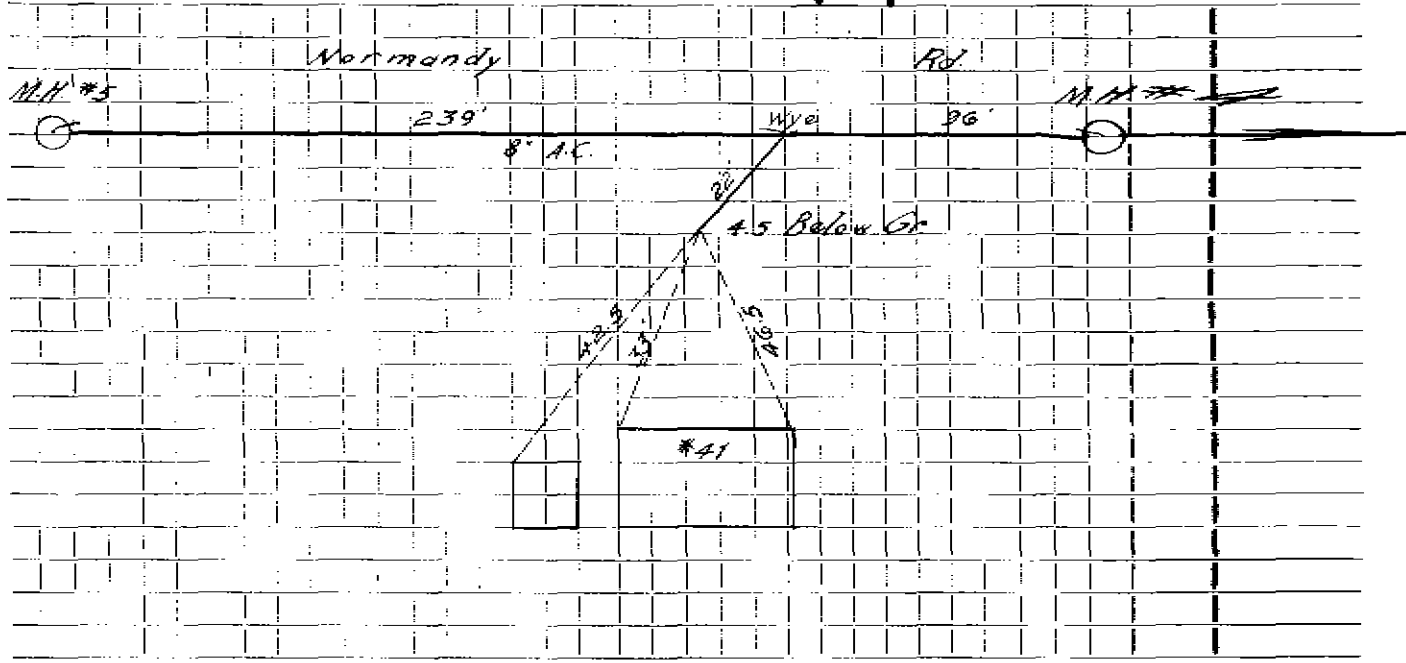

Connection made in ..... Street. Work completed .....

Remarks: .....  
.....  
.....