

Name Benjamin Franklin Homes

Service No. 122

Address <sup>No.</sup> 359 Emerson Road

Lot 31 Sta. 9+11

Location

Kind of Pipe Permit #418

Size

Size of Main

~~Repair~~ ~~Renewal~~ New Service Richard Stevens

Location DEC 31 1965

Date	Material	Amount	Total	Date	Amount
<del>12-62</del>	Labor	33.07		<del>8-2-65</del>	97.53
	10% O.H.	3.31	36.38		
<del>39'</del>	<del>6" Transite pipe @.82</del>		<del>31.98</del>		
<del>3</del>	<del>11 1/4" Transite Bends @4.09</del>		<del>12.27</del>	9-12-62	
<del>1</del>	<del>22 1/2" Transite Elbow</del>		<del>2.35</del>	39'	6" Transite
<del>1</del>	<del>Duplex Adapter</del>		<del>1.62</del>	3	6"-11 1/4" Bends
1	6" Transite End Cap		1.93	1	6"-22 1/2" Elbow
2	hrs. Trucking @3.00		6.00	1	Duplex Adapter
5	hrs. Pumping @1.00		5.00		
	BILL WHEN CONNECTED		97.53		
2-65	82' 6" Transite pipe				


122

DATE \_\_\_\_\_

TOWN OF LEXINGTON — BOARD OF PUBLIC WORKS

SEWER DIVISION

Sketch of Service Here

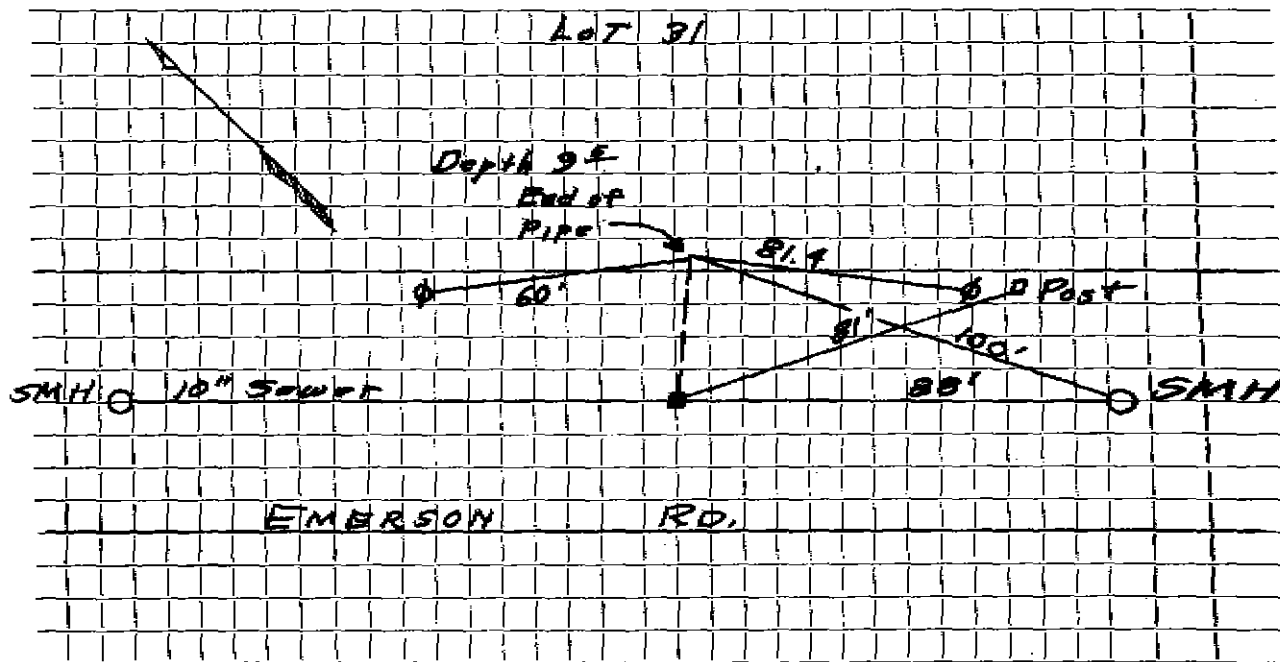

Connection made in ..... Street. Work completed .....

Remarks: .....

.....

.....