

Name ~~Candy Standby - Stout~~

Service No.

Address 367 North Emerson Road

367 N. Emerson Rd.

Location

Kind of Pipe

PVC

Size

6

Size of Main

10"

~~Residence~~ - New Service Parkwood #3805

Location

Date	Material	Amount	Total	Date	Amount
------	----------	--------	-------	------	--------

7/27/83 86' 6" PVC

10' 4" PVC

1 6" x 4" Donut

1 22° Elbow

1 6" x 6" Tee

1 6" Cap

367 & 369 USC some Ch.m.
on 10" main 30ft deep

DATE _____


TOWN OF LEXINGTON — BOARD OF PUBLIC WORKS

SEWER DIVISION



Sketch of Service Here

367

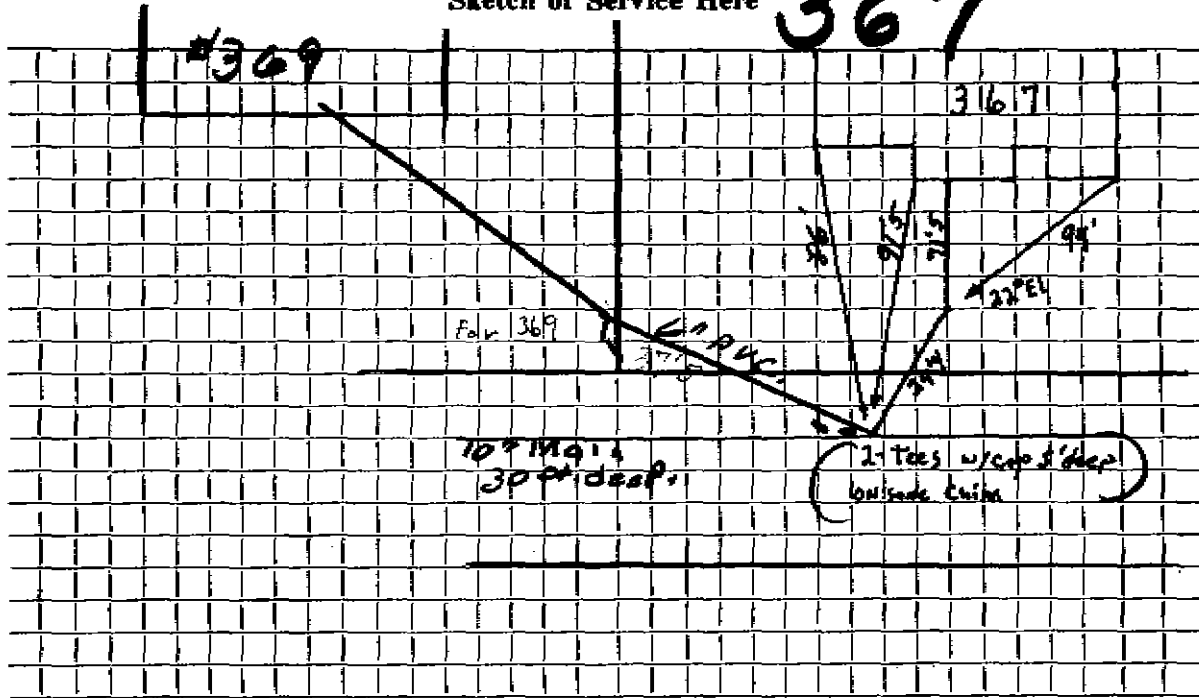

Connection made in Street. Work completed

Remarks: 2 - 6" x 6" PVC Tees - Top tee for 367. Bottom tee for 369.

.....
.....