

Name

Service No.

Address #370 NORTH EMERSON RD

370 N. Emerson Rd. Location LOT 13

Kind of Pipe PVC

Size 6"

Size of Main 10" A.C.


Repair—Renewal—New Service Location

Date	Material	Amount	Total	Date	Amount
5-3-84	73 ft. 6" PVC				
11/22/84	36 ft. 6" PVC.				
	10 ft. 4" CJ				
	① 22" bend				
	① donut				

DATE \_\_\_\_\_

TOWN OF LEXINGTON — BOARD OF PUBLIC WORKS

SEWER DIVISION

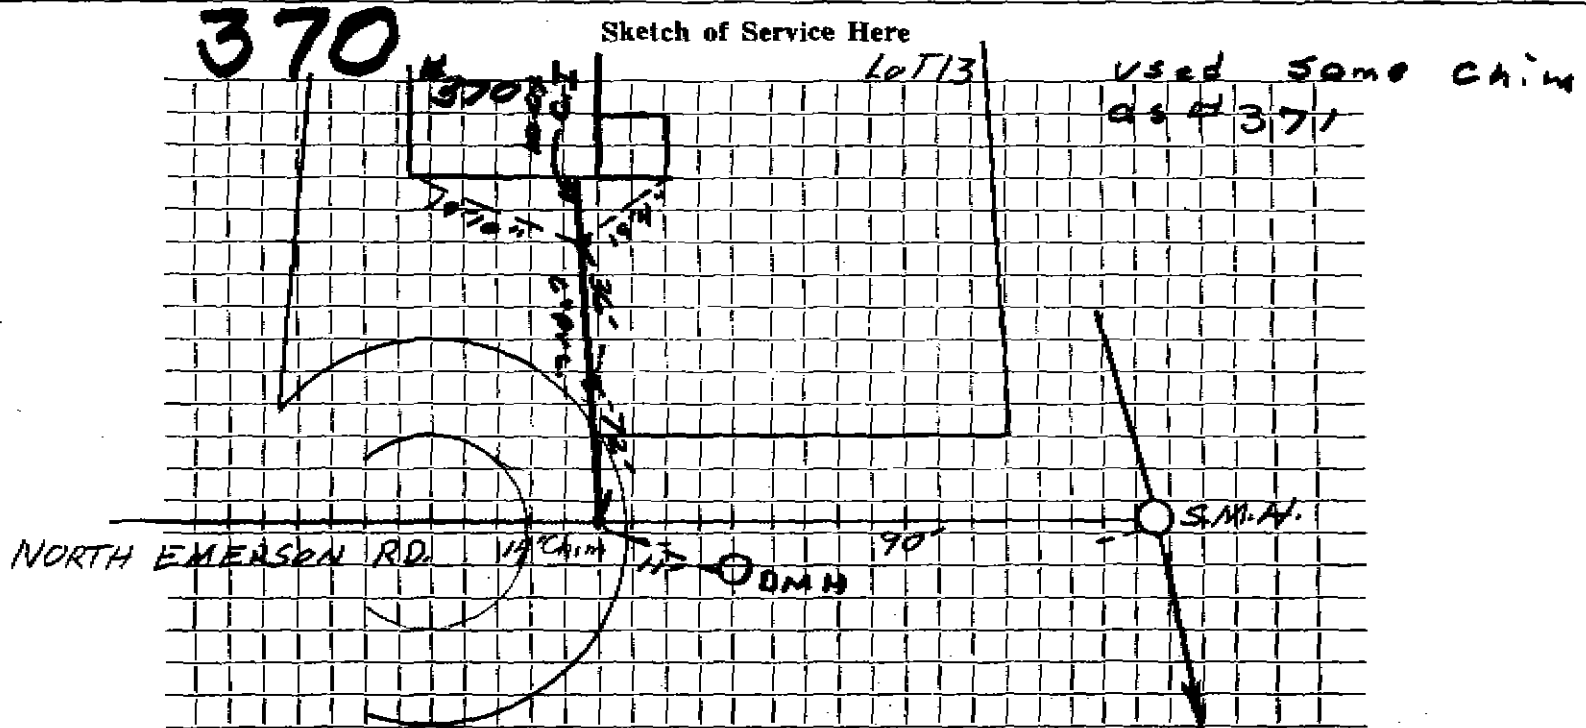

Connection made in ..... Street. Work completed .....

Remarks: .....