

Name **Moore Realty Trust**

Service No. **18**

Address **102 North Hancock Street**

102 N. HANCOCK ST.

Location

Kind of Pipe

Size **6"**

Size of Main

~~Revised Estimate~~ **New Service** V.O. #7830

Location **Comm 6-3-63**


Date	Material	Amount	Total	Date	Amount	
4-25-63	Labor	23.82		4-9-63	Deposit	250.00
4-26-63	"	98.60	122.42	4-3-63	Paid by SHC #19	21.31
	10% O.H.	12.24	134.66			271.31
	60' 6" Transite pipe @.82		49.20			
	1 6" x 12" Transite Nipple		5.75			
	2 11 1/2" Transite Elbows @2.35		4.70			
	4 hrs. Town Shovel @6.50		26.00			
	3 hrs. Trucking @3.00		9.00			
	2 hrs. Compressor @5.00		10.00			
	24 x 4 Patch		32.00			
			271.31			

DATE _____

TOWN OF LEXINGTON — BOARD OF PUBLIC WORKS
SEWER DIVISION

Sketch of Service Here

102

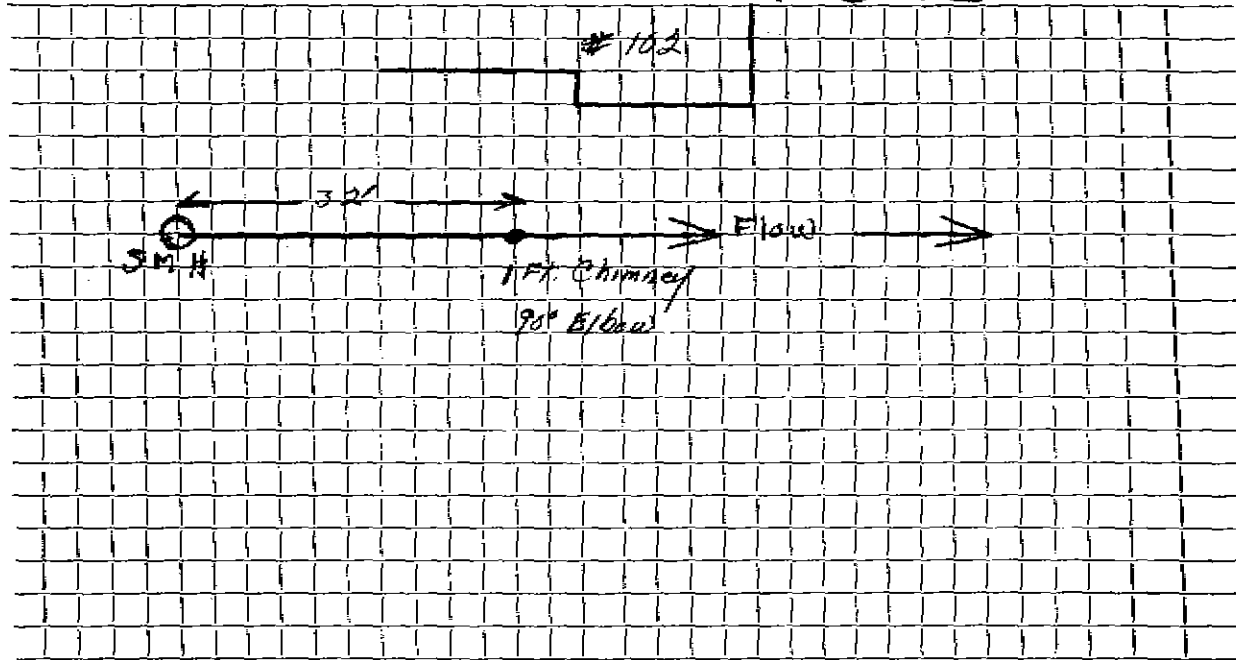

Connection made in Street. Work completed

Remarks:

.....

.....